20 TOWN 06 RANGE

ADAMS COUNTY

COUNTY CORNER NO: 80

ROMPORTOL ID: 42006242000

PUBLIC LAND SURVEY MONUMENT RECORD

TYPE OF MONUMENT: HARRISON ADAMS COUNTY COORDINATES, NAD 83 (2007)

N. **300964.190**

E. 557108.345


ELEVATION- - - DATUM - - -

FIELD WORK DATE: 02/06/2018

BASIS FOR MONUMENT LOCATION

1982 - PLS 1167 TRAVERSED AREA AND SEARCHED LOCATION. UNABLE TO LOCATE ANY EVIDENCE TO THE ORIGINAL CORNER OR ANY REMONUMENTED CORNER. CALCULATED THE CORNER MIDWAY ON A STRAIGHT LINE BETWEEN EXISTING SECTION CORNERS. SET A HARRISON MONUMENT AT CALCULATED LOCATION AND TIED OUT.

2018 - PLS 2994 FOUND A HARRISON MONUMENT FLUSH WITH THE GROUND SURFACE AND 1 WITNESS TREE. THE MONUMENT AGREES WITH THE EXISTING WITNESS TREE. ACCEPTED THE HARRISON MONUMENT AS THE CORNER LOCATION. SET 4 NEW TIES AND MEASURED TO THE TIES AND WITNESS TREE.

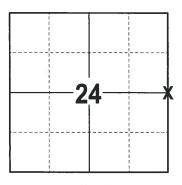

LOCATION (INDICATE CORNER BY "X")

TIMOTHY G.
RUTZEN, JR.
S-2994
MOSINEE,
WISCONSIN

DATA SHOWN HERE ON THIS TIE SHEET IS CORRECT AND COMPLETE TO THE BEST OF MY KNOWLEDGE AND BELIEF.

PROFESSIONAL LAND SURVEYOR


DATE 3-1-18

- TIE SKETCH

NOTE: THE CORNER FALLS 3'± SOUTH OF THE MAINTAINED FENCE.



BRUSH/SMALL TREES

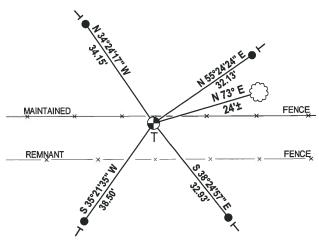

● 3/4" x 18" IRON REBAR SET, 1.50#/FT → HARRISON FOUND → VINYL "T" POST

FOUND WITNESS TREE

OPEN HARDWOODS

Government Land Corner Certificate CORNER NO. County **SECTION** TYPE OF MONUMENT: . 20 TOWN STATE PLANE COORDINATES: N RANGE ELEVATION — M.S.L. DATUM: . THETA ANGLE: _ FIELD BOOK: _ PAGE Baslez DRAWN BY: _ BASIS FOR MONUMENT LOCATION Show info such as: History of corner, with reference to Vol. and pg., dates, surveyor; exact description of monument replaced; if location computed, by taped or EDM traverse; landowner remarks, etc. (Use reverse side if necessary) LOCATION (Indicated by 'X') SEAL: Traversed area to locate search location. Unable to locate any evidence to original corner or of any remonumented corner. Set corner midway on a straight line between existing Section orners. WAYNE HASLER 1107 WIS. PATIDE DATA SHOWN HERE ON CERTIFIED, CORRECT: Registered Land Surveyor DATE: TIE SKETCH Show at least four ties, also fence lines, roads, topo, size and type of witness trees' and if off road - best way to POPPLE / SIEN FACINO arrive at corner. CHERR 23.8 4'N. of FRC '09 ਤ′± Trail In MAPLE 41 D.N.D. 5191 PEAD

MAINTENANCE RECORD

| DATE | BY WHOM | REMARKS |
|---------|---------|------------|
| 5-17-89 | SS | Z NEW TIES |
| 3-03-09 | 55 | 2 " " |
| | | |
| | | |
| * | | |
| | | |
| | | |
