ADAMS COUNTY COUNTY CORNER NO: 84

ROMPORTOL ID: 42006200020

PUBLIC LAND SURVEY MONUMENT RECORD

TYPE OF MONUMENT:_	MAG SPIKE	
ADAMS COUNTY COORDINATES, NAD 83 (2007)		
N 298144.580		
E. 533238	.857	
ELEVATION-	DATUM 	
FIELD WORK DATE:	05/10/2018	:

BASIS FOR MONUMENT LOCATION

1976 - PLS 1103 RAN E.D.M./TRANSIT TRAVERSE AROUND SECTIONS 29 AND 32 TO DETERMINE SEARCH AREAS. DID NO EXCAVATE BECAUSE THE SEARCH AREA FALLS IN THE CONSTRUCTION AREA OF STATE HIGHWAY 13. CALCULATED THE CORNER ON-LINE BETWEEN THE ADJACENT SECTION CORNERS AND PROPORTIONALLY TO THE ORIGINAL GOVERNMENT SURVEY DISTANCES. SET HARRISON AND TIED OUT.


1989 - PLS (UNKNOWN) RE-SET 1"x12" IRON ROD AT CORNER LOCATION.

FOUND WISDOT ALUMINUM CAP IN CONCRETE


FOUND MAG SPIKE WITNESS TREE

2008 - PLS 2663 PRIOR TO ROAD CONSTRUCTION OF STH 13, FOUND A RAILROAD SPIKE THAT WAS CONSISTENT WITH SURVEY MONUMENT RECORDS ON FILE. ACCEPTED ITS LOCATION. AFTER COMPLETION OF ROAD CONSTRUCTION, THE RAILROAD SPIKE HAD BEEN DISTURBED. RE-SET A 30IN. HARRISON MONUMENT AND TIED OUT.

2018 - PLS 2994 FOUND A MAG SPIKE IN THE ROAD SURFACE, 4 TIES AND 1 WITNESS TREE. REMOVED MAG SPIKE AND FOUND NO EVIDENCE OF ANY OTHER MONUMENTATION BELOW. THE MONUMENT AGREES WITH 3 OF THE 4 EXISTING TIES AND THE WITNESS TREE. ACCEPTED THE MAG SPIKE LOCATION AS THE CORNER LOCATION, RE-SET THE MAG SPIKE AT IT'S LOCATION AND RE-MEASURED TO THE TIES AND WITNESS TREE.

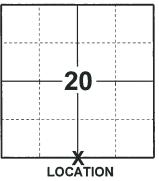


(INDICATE CORNER BY "X")

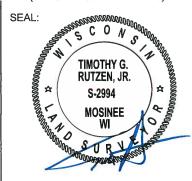

DATA SHOWN HERE ON THIS TIE SHEET IS CORRECT AND COMPLETE TO THE BEST OF MY KNOWLEDGE AND BELIEF.


PROFESSIONAL LAND SURVEYOR

7-18-18

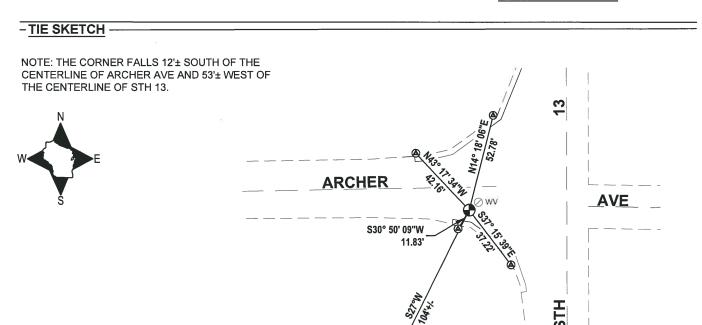

ADAMS COUNTY SURVEY MONUMENT RECORD

TYPE OF MONUMENT:	HARRISON MONUMENT
STATE PLANE COORDINATES:	N
	E
ELEVATION:	
FIELD BOOK:	PAGE

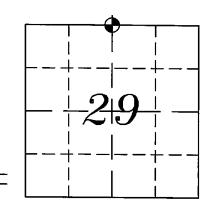

CORNER NO.

SECTION 29 TOWN 20 NORTH RANGE 6 EAST

ROME CITY, VILLAGE, TOWN



BASIS FOR CORNER LOCATION:

PRIOR TO ROAD CONSTRUCTION OF STH 13 FOUND A RAILROAD SPIKE THAT WAS CONSISTENT WITH SURVEY MONUMENT RECORD ON FILE AND ACCEPTED ITS LOCATION. AFTER COMPLETION OF ROAD CONSTRUCTION THE RAILROAD SPIKE HAD BEEN DISTURBED. SET A 30in. HARRISON MONUMENT

DARREN B.

KRZANOWSKI

S-2663

MOSINEE.

WILL

REGISTERED MAND SURVEYOR

DATE: 22 SEPTEMBER 2008

CORNER NO. ADAMS COUNTY SECTION Survey Monument Record RESET (1989) 20 TOWN -Harrison 1/2" x 12" IRON ROD TYPE OF MONUMENT: RANGE STATE PLANE COORDINATES: N ELEVATION - M.S.L. DATUM: _ THETA ANGLE: _ 37 28 FIELD BOOK: ___ PAGE BASIS FOR MONUMENT LOCATION (Use reverse side if necessary) LOCATION Show info such as: History of corner, with reference to Vol. and pg, dates, surveyor; exact description of monument replaced; if location computed, by taped or EDM traverse; landowner (Indicated by 'X') SEAL: Ran EDM/transit traverse around Sections 29 and 32 to determine search areas. Did not excavate because search area falls with the Z. S-1103 construction area of State Highway 13. Wisconsin Rapids. Set corner on line, between the adjacent section corners proportionally to the original government survey distances. Set 4-15-1976: 1-gone no new 5-7-84 SS-DK CERTIFIED CORRECT: OK 6-7-79 RN-RN 3MARCH94 CR-JG OK OK 12-28-98-JG 1-GONE, 1-29-04 JG-DA DATE: 6-1-1976 TIE SKETCH "GONE" 12" Jack Pine / at (Show at least four ties) 3 ROTE Ties in trees to nail in disc. P.K. NAIL AT NORTH END OF CONC. CURB. (1989) 91.15 A VE

Chisel cross

SET 3/4"x 24" ROD . 117. 56 0.3' SOUTH OF R.O. W. POST (1989) 105.01