06 ADAMS COUNTY COUNTY

PUBLIC LAND SURVEY MONUMENT RECORD

HARRISON TYPE OF MONUMENT: ADAMS COUNTY COORDINATES, NAD 83 (2007) N. 298296.944 E. 546476.502 ELEVATION- - - DATUM - -05/22/2018 FIELD WORK DATE:___


BASIS FOR MONUMENT LOCATION

1981 - PLS 878 NO RECORD OF ANY RESURVEYS. PERRY-CARRINGTON SURVEY FOR BURT MORRIS DOES NOT SHOW A CORNER AT THIS LOCATION. COULD NOT FIND ANY EVIDENCE OF THE ORIGINAL OR SUBSEQUENT MONUMENT. THIS CORNER WAS ESTABLISHED BY DOUBLE PROPORTIONATE METHOD. SET A HARRISON AND TIED

2018 - PLS 2994 FOUND A HARRISON MONUMENT 6" UNDER THE WATER NEXT TO A RAILROAD TIE FENCE POST. FOUND NO EVIDENCE OF ANY OF THE WITNESSES. ACCEPTED THE HARRISON MONUMENT AS THE BEST EVIDENCE OF THE CORNER LOCATION. SET 4 NEW TIES AND MEASURED TO THE TIES.



(INDICATE CORNER BY "X")

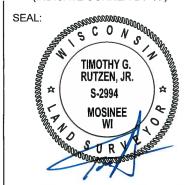

DATA SHOWN HERE ON THIS TIE SHEET IS CORRECT AND COMPLETE TO THE BEST OF MY KNOWLEDGE AND BELIEF.


PROFESSIONAL LAND SURVEYOR

DATE 7-18-18

-TIE SKETCH -


NOTE: THE CORNER FALLS 1'± WEST OF THE FENCE LINE.



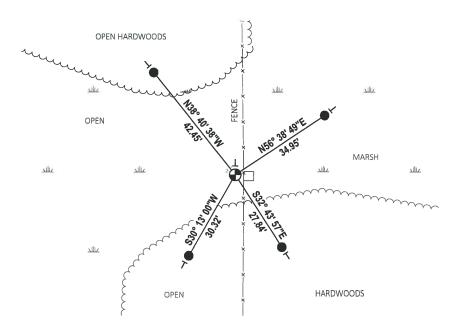

- SET 3/4" x 18" IRON REBAR, 1,50#/FT
- FOUND HARRISON MONUMENT
- RAILROAD TIE W/DND SIGN
- VINYL "T" POST

Government Land Corner Certificate 89 CORNER NO. Adams County 27 **SECTION** TYPE OF MONUMENT: Harrison 20 **TOWN** STATE PLANE COORDINATES: 6 RANGE ELEVATION — M.S.L. DATUM: _ THETA ANGLE: FIELD BOOK: 86 ____ PAGE _______ DRAWN BY: T. H BASIS FOR MONUMENT LOCATION Show info such as: History of corner, with reference to Vol. and pg., dates, surveyor; exact description of monument replaced; if location computed, by taped or EDM traverse; landowner remarks, etc. (Use reverse side if necessary) LOCATION ANTHON KIE SEAL: No record of resurveys. Perry-Carrington survey for Burt Morris does not show a corner here. Could find no evidence of original or subsequent monument. This corner set by double proportionate method. Wisconsin Rapids SURY DATA SHOWN HERE ON CERTIFIED CORRECT: Registered Land Surveyor 1/3/81 DATE: R.R. TIE FENCEPOST TIE SKETCH Show at least four ties, also fence lines, roads, topo, size and type of witness trees' and if off road - best way to 6" BIK OAK'DS arrive at corner.

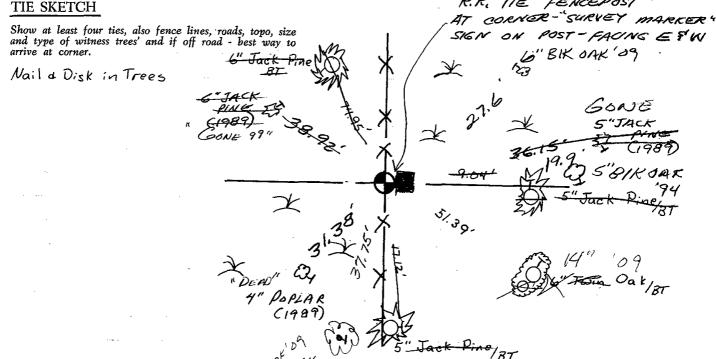

BLK DAK

MAINTENANCE RECORD

DATE	BY WHOM	REMARKS
6-13-89	MK-55	3 NEW 71ES
3.8-94	55 55	/ "
4-8-99	JG-SS	1-GONE /-NEW, MON. OK
3.8-94 4-8-99 12-17-69	55	I NEW TIE
		·