# 06 RANGE ADAMS COUNTY COUNTY CORNER NO: 92 ROMPORTOL ID: 42006240020


## PUBLIC LAND SURVEY MONUMENT RECORD

1-1/4" O.D. IRON PIPE TYPE OF MONUMENT: ADAMS COUNTY COORDINATES, NAD 83 (2007) N. **298321.560** E. 554472.931 **ELEVATION-**DATUM 05/23/2018 FIELD WORK DATE:\_


#### BASIS FOR MONUMENT LOCATION

1980 - PLS 1478 CALCULATED POSITION EQUIDISTANT AND ON LINE BETWEEN ADJACENT SECTION CORNERS. NO EVIDENCE OF PREVIOUS MONUMENTATION WAS FOUND, NO RECORD OF MONUMENTATION SUBSEQUENT TO THE ORIGINAL WAS FOUND, SET HARRISON AND TIED OUT.

2018 - PLS 2994 FOUND A 1-1/4" O.D. IRON PIPE 12" ABOVE THE GROUND SURFACE AND 2 WITNESS TREES. THE MONUMENT AGREES WITH THE EXISTING WITNESS TREES, ACCEPTED THE 1-1/4" O.D. IRON PIPE AS THE CORNER LOCATION, SET 4 NEW TIES AND MEASURED TO THE TIES AND WITNESS TREES.

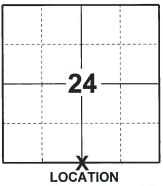

(INDICATE CORNER BY "X")

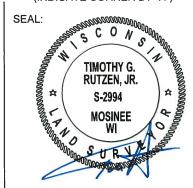

DATA SHOWN HERE ON THIS TIE SHEET IS CORRECT AND COMPLETE TO THE BEST OF MY KNOWLEDGE AND BELIEF.

PROFESSIONAL LAND SURVEYOR


7-18-18 DATE

#### -TIE SKETCH

NOTE: THE WITNESS TREE IS S68°E, 65'± FROM THE CORNER LOCATION.



- SET 3/4" x 18" IRON REBAR, 1.50#/FT
- FOUND 1-1/4" O.D. IRON PIPE
- VINYL "T" POST
- WITNESS TREE

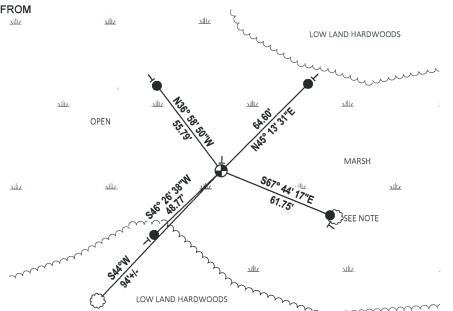

Government Land Corner Certificate			<b>~</b>
Q /s van Country	MON. 15 14 5-16-8	CORNE	
TYPE OF MONUMENT HOUSE Standard	1" Iron Pipe	SECTIO	
TYPE OF MONUMENT: Harrison Standard STATE PLANE COORDINATES: N	-Harrison +	೧ ೧೬ TOWN	
E	1997	RANGE	6
ELEVATION — M.S.L. DATUM:		[ <del></del>	, 
THETA ANGLE:	<del></del>		
DRAWN BY: G. Rhinehart			
	<del></del>	<u> </u>	S-IN
BASIS FOR MONUMENT LOCATION			
Show info such as: History of corner with reference to Vol			
and pg., dates, surveyor; exact description of monument		LOCATI	ION
landowner remarks, etc. (Use reverse side if necessary)	SE	(Indicated l	oy 'X')
	1		111///
		GREGORHINE S-14 Wisconsir Wis ATA SHOWN HER	ORY P. HART 178 P. Rapids S.
Set monument equidistant and on	line	Sala Advisor	12 1
between adjacent Section Corner	,	GREGO RHINE	)RY P. \☆ I
No evidence of previous monume.	ntation	S-14 Wisconsin	78 Bapids
was found. No record of monun	nentation	Wi	5.
subsequent to the original was	found.	The Contract of the Contract o	ALL CALLS
		AND SI	JRVE
	מ	ATA SHOWN HER	E ON
-		ERTIFIED CORREC	
		They ory	P Rhineha
		egistered Logid Survey	or Ze /os
	D	ATE:	-7/80
TIE SKETCH		γ-	6"ELM 109
Show at least four ties, also fence lines, roads, topo, size	6"81x edo <b>c</b> x	Two 4"	STNYOE 75.5 Boxelder/-
and type of witness trees' and if off road - best way to arrive at corner.	1922	(8)	SIETY
199 THIS TREE 15	(ES)	Yi)	•
PPEN EASTERST. STILL	12 Th	19 19 19 19 19 19 19 19 19 19 19 19 19 1	BUELDER
WE - NOTE DIST. DRANGE BT REPORTET	129- B	, () 3.	BOXELDER/SIGN
24 262 1		67.	PEAD '09
SECON OS	C. 25.		
,—————————————————————————————————————		<del>-</del> :	
*55436	18 39	• / <u>^</u>	0500
-199- 7000 30		CZ CL	USTER OF (A)
NEW 5" MAPLE Q 7" Poplar	<b>B</b>		1122012 122012
18/	- 5-	STUM	p to
1989 D.N.D.	Sign En	10" Paplax 187	54
4" MARCE,	1	GONE 94	64.51
5/6/*			3" &M - IN
	•	4	CLUSTER of 3
			-

### MAINTENANCE RECORD

DATE	BY WHOM	REMARKS
5-16-89	SS	2 New 71ES
	J6-CR	1-GONE, 1-NEW TIE
3-5-99	55	Z NOW THE - I ADJUSTED THE
8-10-04	s5	11 4
3-04-09	55	STILL I I P 2 NOW TIES
	·	