06 RANGE ADAMS COUNTY CORNER NO: 102 ROMPORTOL ID: 4200630020


PUBLIC LAND SURVEY MONUMENT RECORD

HARRISON (BROKEN-TOP) TYPE OF MONUMENT: ADAMS COUNTY COORDINATES, NAD 83 (2007) N. 292841.344 E. 528081.805 ELEVATION- - - DATUM FIELD WORK DATE:_ 05/29/2018


BASIS FOR MONUMENT LOCATION

1981 - PLS 1167 FOUND A 1-1/2" x 36" IRON PIPE WITH CROSS BARS NEAR THE BOTTOM, ACCEPTED SAID PIPE AS THE CORNER LOCATION AND REPLACED IT WITH A HARRISON MONUMENT AND TIED OUT.

2018 - PLS 2994 FOUND A HARRISON MONUMENT WITH A BROKEN-TOP 24" BELOW THE GROUND SURFACE, 1 TIE AND 2 PROPERTY IRONS, THE MONUMENT AGREES WITH THE EXISTING TIE. ACCEPTED THE HARRISON MONUMENT WITH A BROKEN-TOP AS THE CORNER LOCATION. SET 1 NEW TIE (USED THE 2 PROPERTY IRONS AS TIES) AND MEASURED TO THE TIES.

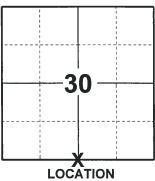

(INDICATE CORNER BY "X")

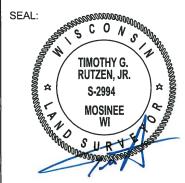

DATA SHOWN HERE ON THIS TIE SHEET IS CORRECT AND COMPLETE TO THE BEST OF MY KNOWLEDGE AND BELIEF.

PROFESSIONAL LAND SURVEYOR


7-18-18

-TIE SKETCH

NOTE: THE CORNER FALLS 2'± SOUTH OF THE CENTERLINE OF EAST-WEST FIRE LANE AND 6'± WEST OF THE CENTERLINE OF THE NORTH-SOUTH FIRE LANE ..



- SET 3/4" x 18" IRON REBAR, 1,50#/FT FOUND 3/4" IRON ROD
- FOUND 1-1/4" O.D. IRON PIPE
- FOUND HARRISON MONUMENT (BROKEN-TOP)
- VINYL "T" POST
- WITNESS TREE

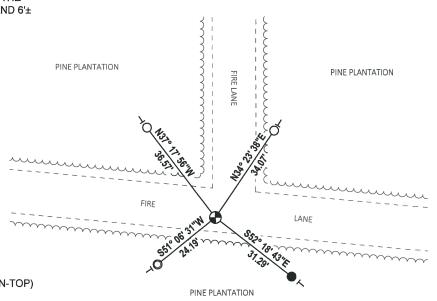

Government Land Corne	er Certificate		•	
ADAMS	County		CORNER NO.	102
TYPE OF MONUMENT: HARRISO	Councy On		SECTION	30
STATE PLANE COORDINATES: N_			TOWN	
. E			RANGE	
ELEVATION — M.S.L. DATUM:				
THETA ANGLE: FIELD BOOK: LL	DA CIT	1		
DRAWN BY: R. Muber	PAGE			
			 	- N
BASIS FOR MONUMENT LOCA	ATION			
Show info such as: History of corner, with	h reference to Vol.			İ
and pg., dates, surveyor; exact description replaced; if location computed, by taped landowner remarks, etc. (Use reverse side	ion of monument or EDM traverse;	'	LOCATION	
		SEAL:	(Indicated by 'X')	500500
Searched for and found withcross bars near the	1½"x36" iron pipe	4.a.l	And Property Control	O 35 g man
pipe and replaced with	HARRISON MON.	-α	a de la companya della companya della companya de la companya della companya dell	
DK 5-7-84 RK-SS				
OK. 1-18-89 55		1 1	WAYNE	BASLER
OK 3-3-94 CR-JG			Wis. R	BASLER 67 APIDS, S.
1K 12-28-98 JG			WI	S.
OK 3-17-04-56			TO SU	RVEREELER
OK 2.2-09 55	•		在东京这里(AKA BULE
		DATA S	HOWN HERE ON	ī
	•	CERTIF	ED CORRECT:	_ ,
		16	Affair Land Surveyor	asle
			<u>6-15</u>	-91
		DATE:		<u> </u>
TIE SKETCH				
Show at least four ties, also fence lines, 1	roads, topo, size 🗸 09	18'-		
and type of witness trees' and if off road arrive at corner.	d - best way to	10-7	12"	JACK PINT BLAZE
with at corner.	O WIT.	+WE	15 (JACK PINT SIGN & BLAZE DEAD / NAIL STILL
	×	C)RELANE		6000
•	5 8.11°	14	3 ^{H . 1} H	
	G FIRELANE 4		2	
	±6'			
)		•
	, O ₄ ,	1 3/2/6	3" BLACK ONK	
	55 ⁴ 24.23		BLAZE	.
•	V09 0		SICN	
	1"x36" I.P.			
	WIT.			
			· •	
DECEMEN	PLANTED	NOPWA	17	
11(e130/61)11	SEED	111465		

MAINTENANCE RECORD

DATE	BY WHOM	REMARKS

· · · · · · · · · · · · · · · · · · ·		
		<u> </u>