ADAMS COUNTY COUNTY CORNER NO: 106

ROMPORTOL ID: 42006280020

PUBLIC LAND SURVEY MONUMENT RECORD

CALCULATED POSITION TYPE OF MONUMENT: ADAMS COUNTY COORDINATES, NAD 83 (2007) N. 292890.814 E. 538646.181 ELEVATION- - - DATUM_ FIELD WORK DATE: 05/29/2018


BASIS FOR MONUMENT LOCATION

1974 - PLS 1103 NO EVIDENCE AS TO THE LOCATION OF THE CORNER IS APPARENT IN THE FIELD BECAUSE THE CORNER FALLS WITHIN A LARGE SWAMP. RAN EDM TRAVERSE OF SECTION 28 AND RE-ESTABLISHED CORNER USING ORIGINAL NOTES. SET TIES ONLY.

2018 - PLS 2994 FOUND 2 TIES ON LINE AND 2 EXISTING WITNESS TREES, BOTH SUPPORTING THE TIES. ACCEPTED THE TIES AS CORRECT. CALCULATED THE CORNER LOCATION BY EXTENDING THE LINE BETWEEN THE 2 FOUND TIES, SOUTH INTO THE DORRO COUCHE SWAMP A DISTANCE OF 500', AS SHOWN ON PRIOR TIESHEET. SET 2 NEW WITNESS TREES PER TIE AND MEASURED TO THE TIES AND WITNESS TREES.



(INDICATE CORNER BY "X")

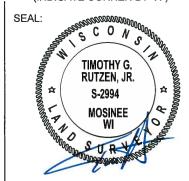

DATA SHOWN HERE ON THIS TIE SHEET IS CORRECT AND COMPLETE TO THE BEST OF MY KNOWLEDGE AND BELIEF.

PROFESSIONAL LAND SURVEYOR

7-18-18 DATE

-TIE SKETCH


NOTE: ALL TIES ARE TO NAILS IN TREES.



FOUND 1-1/2" O.D. IRON PIPE W/ALUMINUM CAP

عالد

- FOUND 1-1/4" O.D. IRON PIPE
- CALCULATED POSITION OF CORNER
- VINYL "T" POST
- WITNESS TREE

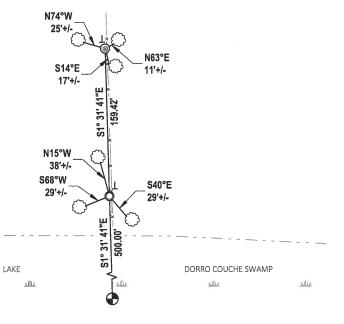

ADAMS COUNTY CORNER NO. 28 SECTION Survey Monument Record 20 TOWN TYPE OF MONUMENT: _ Ties Only 6 E RANGE STATE PLANE COORDINATES: N. ELEVATION — M.S.L. DATUM: THETA ANGLE: . FIELD BOOK: ____111 13 _ PAGE _ BASIS FOR MONUMENT LOCATION (Use reverse side if necessary) LOCATION Show info such as: History of corner, with reference to Vol. and pg, dates, surveyor; exact description of monument replaced; if location computed, by taped or EDM traverse; landowner (Indicated by 'X') SEAL: remarks, etc. No evidence as to location of the corner is apparent in the field because corner falls within large swamp. Ran EDM traverse of Section 28 and DALE C. re-established corner using original notes. HAGEN S-1103 OK- 5-8.89 WIS. RAPIDS WIS. OK 7-13.79 RN-RN 1-GONE, 1-NEW TIE 3-14-94 JG-SS CERTIFIED CORRECT: 4-9-99-56-55 Da 1 - NEW THE WITHESS CORNERS OR IP OK 3 NOW THES 2-23-09 Registered Lan -DATE: <u>Ma</u>y 12" Black Oak 12" Twin Jack Pine 24.78, TIE SKETCH DND SIGN (Show at least four ties) FACES NOW, 50" by 1-1/2" Galvanized Ties in trees taken to Iron Pipe with "Witness SECTION LINE nail and disc. Corner" stamped in 510°E Aluminum cap. DE AD/DIO SIGN 6"JACK, PINE 09 6" 4" Black Oak O 12.60. 22.40 with sign MAIL H'HIGH & \$580°E 6" BUK OFK LAKE FROM SOUTH PIPE TNOSOE 32.6 DORRO COUCHE 6" JACK PINE, NAIL EAST SIDE- SLOPE SWAMP .09 TAPE

NO CORNER SET.