# ADAMS COUNTY COUNTY CORNER NO: 109 ROMPORTOL ID: 42606270000

## PUBLIC LAND SURVEY MONUMENT RECORD

**SURVEY NAIL** TYPE OF MONUMENT: ADAMS COUNTY COORDINATES, NAD 83 (2007) N. 293008.267 E. 546509.242 ELEVATION-\_ DATUM FIELD WORK DATE:\_ 05/23/2018


#### BASIS FOR MONUMENT LOCATION

1981 - PLS 878 FOUND AND REPLACED A 1" IRON PIPE WITH A HARRISON AND TIED OUT. PIPE SET BY PERRY-CARRINGTON IN A SURVEY FOR BURT MORRIS TO THE NORTH, AND USED BY MIDSTATES FOR A SURVEY TO THE SOUTH. M.C. SMITH SET POST HERE IN 1916, 2/32.

2018 - PLS 2994 FOUND NO EVIDENCE OF A MONUMENT AT THE CORNER LOCATION. RECOVERED 3 TIES AND 2 PROPERTY IRONS, CALCULATED THE CORNER LOCATION OFF THE 3 FOUND TIES AND CHECKED TO THE PROPERTY IRONS. ACCEPTED THIS METHOD TO RE-ESTABLISH THE CORNER LOCATION. SET A SURVEY NAIL AT THE CALCULATED LOCATION AND MEASURED TO THE TIES AND PROPERTY IRONS.



(INDICATE CORNER BY "X")

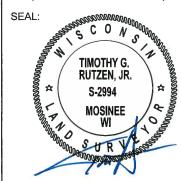

DATA SHOWN HERE ON THIS TIE SHEET IS CORRECT AND COMPLETE TO THE BEST OF MY KNOWLEDGE AND BELIEF.

PROFESSIONAL LAND SURVEYOR


7-18-18 DATE

#### -TIE SKETCH

NOTE: THE CORNER FALLS 4'± NORTH OF THE CENTERLINE OF CTH O.



- O FOUND 3/4" IRON ROD
- FOUND 2-3/8" O.D. IRON PIPE
- FOUND 5/8" IRON ROD
- SET SURVEY NAIL
- STEEL FENCE POST
- VINYL "T" POST

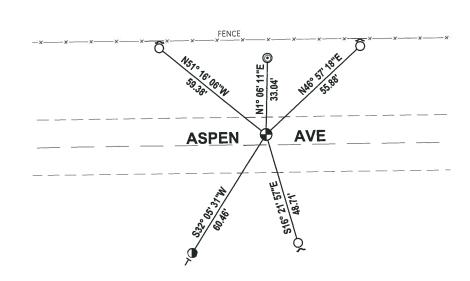

## **Government Land Corner Certificate**

Adams	County	
TYPE OF MONUMENT: Harrison		
STATE PLANE COORDINATES: N		
· <u>E</u>		
ELEVATION — M.S.L. DATUM:		
THETA ANGLE:		
FIELD BOOK: 86 P	AGE 116	
DRAWN BY: T: H.		

### BASIS FOR MONUMENT LOCATION

Show info such as: History of corner, with reference to Vol. and pg., dates, surveyor; exact description of monument replaced; if location computed, by taped or EDM traverse; landowner remarks, etc. (Use reverse side if necessary)

Found and replaced 1" iron pipe. Pipe set by Perry-Carrington in a survey for Burt Morris to the north, and used by Midstates for a survey to the south! M.C.Smith set post here in 1916, per 2/32.

A11 Ok 7-17-84 DK-MK

FO MAG NANC 4'IN. of &


109 CORNER NO. -**SECTION** TOWN



RANGE

6

SEAL:

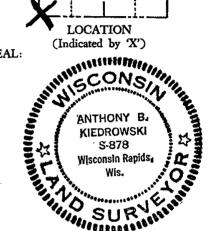

DATA SHOWN HERE ON CERTIFIED CORRECT:

A JL A B Ko Cl Registered Land Surveyor


DATE: 1/2/81

#### TIE SKETCH

Show at least four ties, also fence lines, roads, topo, size and type of witness trees' and if off road - best way to arrive at corner.

Nail & Disk in Trees

POST

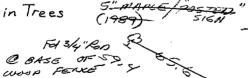

45000

STEBL POST

AUG

## MAINTENANCE RECORD

DATE	BY WHOM	REMARKS
310.194	6R-55	o K
	76-55	TIED INTO FOR 3/4" RODS (3) THES OK CAN'T FIND CORNER
4-9-99	JG	THES OK, CAN'T FIND CORNER
1	j	I and the second