06 ADAMS COUNTY COUNTY CORNER NO: 111

ROMPORTOL ID: 42006260000


PUBLIC LAND SURVEY MONUMENT RECORD

HARRISON TYPE OF MONUMENT:_ ADAMS COUNTY COORDINATES, NAD 83 (2007) N. 293029.194 E. 551843.061 __DATUM_ FIELD WORK DATE:_ 05/23/2018


BASIS FOR MONUMENT LOCATION

1978 - PLS 878 EXCAVATED WITH BACKHOE AND FOUND A 6" x 6" x 12" PURPLE CHIRT STONE. ACCEPTED AS CORRECT DUE TO IT MATCHING CONCRETE REFERENCE MONUMENT AS SHOWN. NO RECORDS OF RESURVEYS. LOWERED STONE AND SET HARRISON MONUMENT ON TOP AND TIED OUT.

2018 - PLS 2994 FOUND A HARRISON MONUMENT 18" BELOW ROAD SURFACE AND 4 TIES. THE MONUMENT AGREES WITH THE EXISTING TIES. ACCEPTED THE HARRISON MONUMENT AS THE CORNER LOCATION. RE-MEASURED TO THE 4 EXISTING TIES.

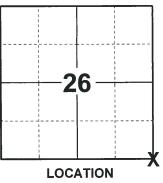

(INDICATE CORNER BY "X")

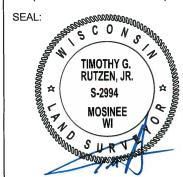

DATA SHOWN HERE ON THIS TIE SHEET IS CORRECT AND COMPLETE TO THE BEST OF MY KNOWLEDGE AND BELIEF.


PROFESSIONAL LAND SURVEYOR

7-18-18 DATE

-TIE SKETCH

NOTE: THE CORNER FALLS 1.5'± SOUTH OF THE CENTERLINE OF CTH O AND 3'± WEST OF THE CENTERLINE OF 8TH AVE.



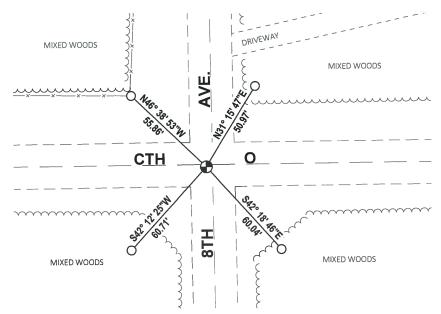

O FOUND 3/4" IRON ROD

FOUND HARRISON MONUMENT

Government Land Corner Certificate /// CORNER NO. ADAMS County سىح SECTION TYPE OF MONUMENT: 20 N TOWN STATE PLANE COORDINATES: 6E RANGE ELEVATION - M.S.L. DATUM: THETA ANGLE: FIELD BOOK: PAGE . DRAWN BY: LANCE HABECK BASIS FOR MONUMENT LOCATION Show info such as: History of corner, with reference to Vol. and pg., dates, surveyor; exact description of monument replaced; if location computed, by taped or EDM traverse; landowner remarks, etc. (Use reverse side if necessary) LOCATION (Indicated by 'X') ANTHONY B. SEAL: Excavated with backhoe. Found 6 x 6 x 12" purple chirt stone. Accepted as correct since it matched concrete reference monument as shown. No records of resurveys. Lowered stone and set Harrison monument on top. S-878 2 new 4-27-84 SS-DK Wisconsin Rapids RETIED CORNER LEFT HARRISON IN PLACE 1.00' DEEP 9/26/02 - JG DATA SHOWN HERE ON CERTIFIED CORRECT: Registered Land Surveyo 1/10/78 DATE: OKAILHOR 344 ROD TREE STILL Show at least four ties, also fence lines, roads, topo, size and type of witness trees' and if off road - best way to EANT arrive at corner. @ 8452 WHITE CEDAR AVE. OK" MAINTENANCE RECORD 9/26/02 Date Init. Remarks 4-13.79 オヤ・55 OK 2-27-89 سہ ہ 55 3<u>-01-</u>94 BR-55 OK Q-16 -99 JG-55 1-GONE, 4-NEW 2-18-04 JG OK Power Pole 3-04-09

6"MAPLE

WAIL & HIGH

No BT

"OK"

9/26/02

REVISED 1977