TOWN

06 RANGE ADAMS COUNTY COUNTY CORNER NO: 118 ROMPORTOL ID: 42006342000


PUBLIC LAND SURVEY MONUMENT RECORD

TYPE OF MONUMENT: HARRISON			
ADAMS COUNTY COORDINATES, NAD 83 (2007)			
N. 290382.974			
E_546580.627			
ELEVATION DATUM			
FIELD WORK DATE: 05/30/2018			

BASIS FOR MONUMENT LOCATION

1981 - PLS 878 NO RECORD OF ANY RESURVEYS. FOUND NO EVIDENCE OF THE ORIGINAL OR SUBSEQUENT MONUMENT. CALCULATED THE CORNER ON LINE AND EQUIDISTANT BETWEEN SECTION CORNERS. THE CORNER FALLS SLIGHTLY WEST OF THE LINE RUN BY AL SCHNEIDER OF MID-STATE IN 1967. SET HARRISON AND TIED OUT.

2018 - PLS 2994 FOUND A HARRISON MONUMENT 12" ABOVE THE GROUND SURFACE AND 2 TIES. THE MONUMENT AGREES WITH THE EXISTING TIES. ACCEPTED THE HARRISON MONUMENT AS THE CORNER LOCATION. SET 2 NEW TIES AND MEASURED TO THE TIES.

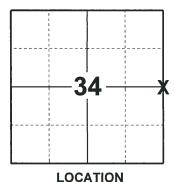

(INDICATE CORNER BY "X")



DATA SHOWN HERE ON THIS TIE SHEET IS CORRECT AND COMPLETE TO THE BEST OF MY KNOWLEDGE AND BELIEF.

PROFESSIONAL LAND SURVEYOR


7-18-18 DATE

-TIE SKETCH

NOTE: THE CORNER FALLS 47'± SOUTHEAST OF THE SOUTHEAST CORNER OF THE TREE STAND.



- SET 3/4" x 48" IRON REBAR, 1.50#/FT
- FOUND 1-1/4" O.D. IRON PIPE
- FOUND 2-3/8" O.D. IRON PIPE
- FOUND HARRISON MONUMENT
- VINYL "T" POST

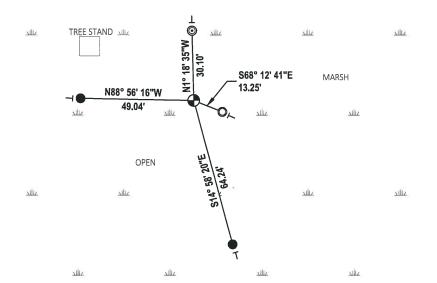

Government Land Corner Certificate CORNER NO. Adams County **SECTION** Harrison TYPE OF MONUMENT: _ 20 TOWN STATE PLANE COORDINATES: 6 **RANGE** ELEVATION — M.S.L. DATUM: _ THETA ANGLE: FIELD BOOK: 86 BASIS FOR MONUMENT LOCATION Show info such as: History of corner, with reference to Vol. and pg., dates, surveyor; exact description of monument replaced; if location computed, by taped or EDM traverse; LOCATION ANTHONY P KIEDP landowner remarks, etc. (Use reverse side if necessary) SEAL: No record of any resurveys, no evidence of original or subsequent monument. Set corner on line and equidistant between section corners. Corner falls slightly west of line run by Al Schneider of Mid-States in 1967. Wisconsin Rapids, Wis. DATA SHOWN HERE ON CERTIFIED CORRECT: Registered Land Surveyor /2/81 DATE: TIE SKETCH Show at least four ties, also fence lines, roads, topo, size and type of witness trees' and if off road - best way to arrive at corner. WITH TREE O = 2" I.P. Found 5729110 ⊕= 1"x24" I.P. of witness OND SIGN ON NEKT TO 49.01 13.3/

 \oplus

MAINTENANCE RECORD

DATE	BY WHOM	REMARKS
2-27-89	SS	BEST TO WALK IN FROM MORTY OK - BRUSHED CINE DISTRICT YET
	56	ALL OK
3-14-94 4-9-99	56 56	ALL OR (TAKE METAL DETECTOR)
		
1	İ	