

PUBLIC LAND SURVEY MONUMENT RECORD

TYPE OF MONUMENT: HARRISON
 ADAMS COUNTY COORDINATES, NAD 83 (2007)

N. 287782.100

E. 557190.287


ELEVATION- DATUM

FIELD WORK DATE: 01/30/2018

BASIS FOR MONUMENT LOCATION


1978 - PLS 878 NO RECORDS OF AND RESURVEYS IN THE AREA. EXCAVATED WITH A BACKHOE AND FOUND A 4"x6"x13" PURPLE CHERT STONE EXACTLY 33' NORTH OF AN AXLE SHAFT. ACCEPTED AS CORRECT AFTER VERIFYING THE LOCATION BY AN EDM TRAVERSE OF THE ENTIRE SECTION. LOWERED THE STONE AND SET A HARRISON MONUMENT ABOVE IT AND TIED OUT.

2018 - PLS 2994 FOUND A HARRISON MONUMENT 12" BELOW THE SURFACE, 1 TIE AND 1 WITNESS. THE MONUMENT AGREES WITH THE EXISTING TIE AND WITNESS. ACCEPTED THE HARRISON MONUMENT AS THE CORNER LOCATION. SET 3 NEW TIES AND MEASURED TO THE TIES AND WITNESS.

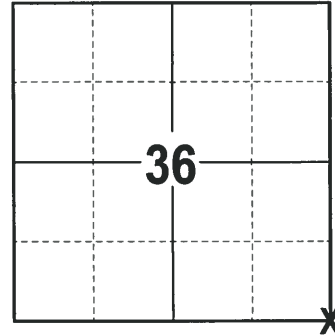

LOCATION
 (INDICATE CORNER BY "X")

SEAL:

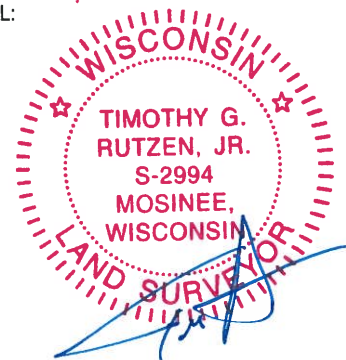



DATA SHOWN HERE ON THIS TIE SHEET IS CORRECT AND COMPLETE TO THE BEST OF MY KNOWLEDGE AND BELIEF.

PROFESSIONAL LAND SURVEYOR

DATE 3-1-18

- TIE SKETCH

NOTE: THE CORNER FALLS 30± SOUTHEAST OF THE CENTERLINES OF BADGER AVE AND ASPEN DR.

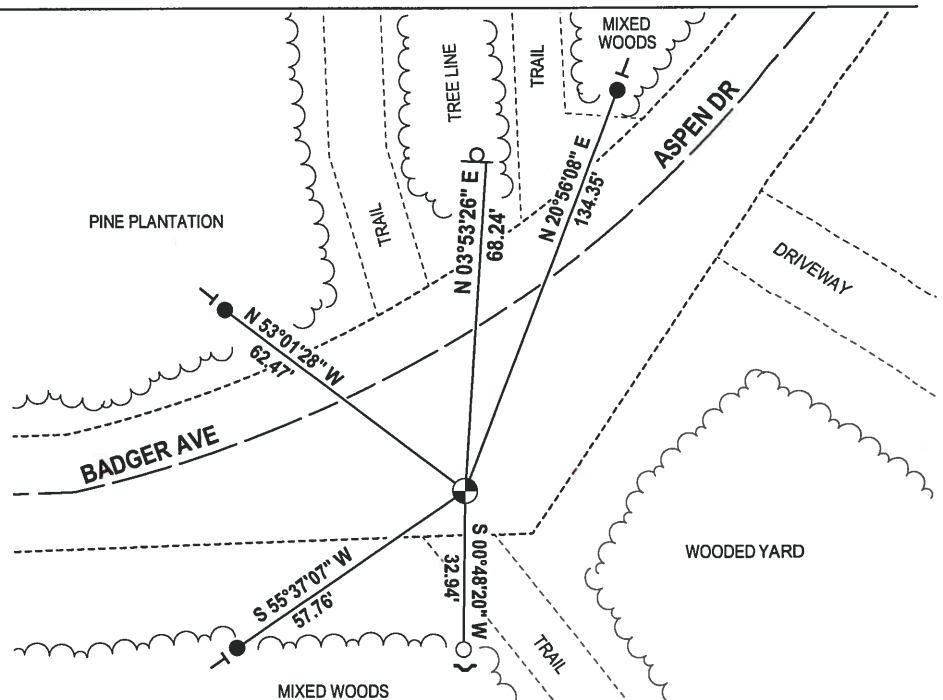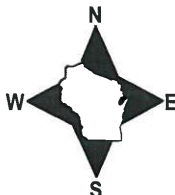

- 3/4" IRON REBAR FOUND
- 3/4" x 18" IRON REBAR SET, 1.50#/FT
- ⊕ HARRISON FOUND
- WITNESS SIGN FOUND
- └ VINYL "T" POST
- ┌ EXISTING STEEL FENCE POST

Government Land Corner Certificate

ADAMS County

TYPE OF MONUMENT: HARRISON

STATE PLANE COORDINATES: N _____
E _____

ELEVATION — M.S.L. DATUM: _____

THETA ANGLE: _____

FIELD BOOK: 101 PAGE 119


DRAWN BY: LANCE HABECK

CORNER NO. 133

SECTION 36

TOWN 20 N

RANGE 6 E

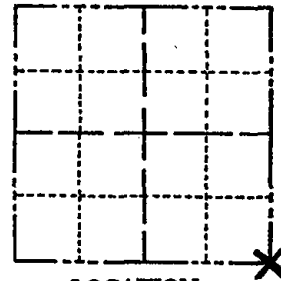

LOCATION
(Indicated by 'X')

BASIS FOR MONUMENT LOCATION

Show info such as: History of corner, with reference to Vol. and pg., dates, surveyor; exact description of monument replaced; if location computed, by taped or EDM traverse; landowner remarks, etc. (Use reverse side if necessary)

Excavated with backhoe. Found 4 x 6 x 13" purple chirt stone exactly 33 feet north of an axle shaft. Accepted as correct after verifying location by EDM traverse of entire section. Lowered stone and set Harrison monument on top. No records of any resurveys in area.

1 gone no new taken 4-27-84 SS-DK

SEAL:



DATA SHOWN HERE ON
CERTIFIED CORRECT:


Anthony B. Kiedrowski
Registered Land Surveyor

DATE: 1/10/78

TIE SKETCH

Show at least four ties, also fence lines, roads, topo, size and type of witness trees' and if off road - best way to arrive at corner.

Ties are to nail and disc.

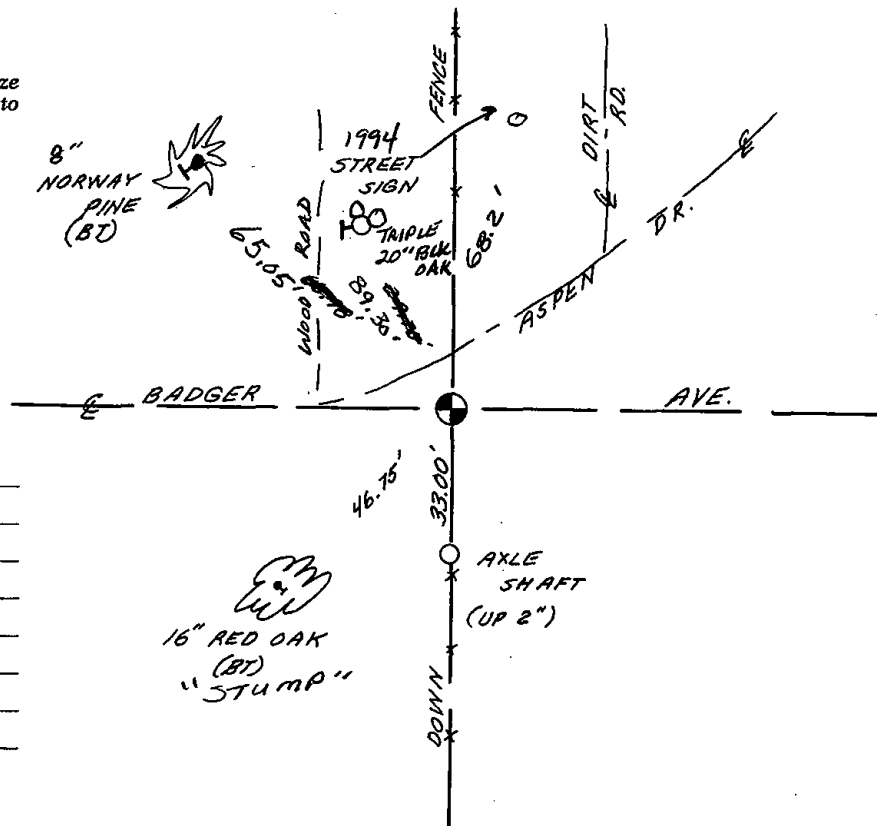

MAINTENANCE RECORD

Date	Init.	Remarks
7-13-79	RN-RW	OK
3-01-74	GR-SS	1 TIE
2-17-99	JG	1-GONE, 2-NEW TIES
2-18-04	JG	OK