SECTION

OT ADAMS COUNTY

COUNTY CORNER NO: 05

ROMPORTOL ID: 42007059000

PUBLIC LAND SURVEY MONUMENT RECORD


1" OD IRON PIPE (NO CAP) TYPE OF MONUMENT: ADAMS COUNTY COORDINATES, NAD 83 (2007) N. 321045.179 E. 567287.808 **ELEVATION-**DATUM - -FIELD WORK DATE: 2/27/2017

BASIS FOR MONUMENT LOCATION

1976 - PLS 878 SET A 1" OD IRON PIPE WITH ALUMINUM HIGHWAY CAP ON A STRAIGHT LINE BETWEEN THE S1/4 AND SW CORNERS OF SECTION 33-21-7 AT A DISTANCE WEST OF THE S1/4 OF 33 AS CALLED FOR IN THE ORIGINAL NOTES. COULD NOT FIND ANY EVIDENCE OF THE CORNER.

1991 - L.L ALLISON FOUND THE 1" IRON PIPE MISSING CAP, SET 4 ALUMINUM CAPED BERNTSEN MONUMENTS AS TIES WITH MARKERS.

2017 - PLS 2994 FOUND A MAG NAIL IN ROAD SURFACE REMOVED DUG DOWN 4 INCHES FOUND A SURVEY NAIL SHAFT, CONTINUED DIGGING AND FOUND A 1" OD IRON PIPE 8 INCHES BELOW THE ROAD SURFACE, FOUND 4 EXISTING TIES. THE 1" IRON PIPE AGREES WITH THE TIES AND WITNESS AND ACCEPTED THE 1" OD IRON PIPE.

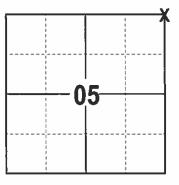

LOCATION (INDICATE CORNER BY "X")




DATA SHOWN HERE ON THIS TIE SHEET IS CORRECT AND COMPLETE TO THE BEST OF MY KNOWLEDGE AND BELIEF.

PROFESSIONAL LAND SURVEYOR



NOTE: THE CORNER FALLS 1'± SOUTH OF THE CENTERLINE OF STH 73. AND 16'± WEST OF 5TH AVE CENTERLINE



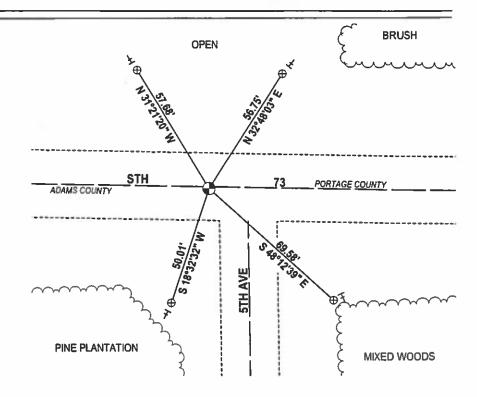

1" OD IRON PIPE FOUND - EXISTING STEEL POST



District	Project 1. C). 321-02-71	Located by	1 / 111	ison		· .
Corner	L	Township	Range (E,W)	Coun	ity .	· · · · · · · · · · · · · · · · · · ·	
<u>IVE</u>	S SECTION ي	1 20 M	1 7E		Adam	7.5	
Wisconsin Co		East (X)		North (Y)	•	Elevation (Z)	Zone
CORNE Control Statio		East (X)		North (V)		F1	
Control State	ii iidiile	Cusi (X)		North (Y)		Elevation (Z)	Zone
			CONTROL	DATUM		<u> </u>	
Horizontal —	- NORTH A	MERICAN, 1927			EAN SEA LE	VEL, 1929 ADJUS	STMENT
Horizontal -	_	Order ·	SURVEY	CONTROL Vertical — _		Order	
				<u>'</u>		01461	
	2	10	SKE'	ГСН		C.	S- + Mai
1	<u>Bernsten M</u>	ntdu.				/	<u>ernsten Mo</u> n
	liwitness	>	58	5° 13' 43 "E		~~^~	Witness cha
Ť	Channel		D = 0	60.83		\sim	
			, `		•	_//	
		0,	Z00		2		
i			2 / E.		215		
			280		N3256.70	}	
	1	1	The state of the s	•	Die 56,		
- (5)		ļ			10"		
	j	- , ,		\times			<u> </u>
++-	· - ! ! 2·1	.473	 {	\ (=14) ()-	,	=	`
_	! !		/				5 /A S
ATION S	CVETCU	als				D=	T 21
-		D.R.		(15 -)	k	0 %	RZE
_ocation of lo indicated by	andmark	0 0		ı	1.0	<u>6</u>	
maicaraa by	^ /	2.0	27		1	29°08 96.14	
		4°56'40 =97.69	05/5		1 11/10	- 6.	
		9-0-	N/20.		1 63]
		m 5/	1) 50° 5		, ,5	3 2	· }
_,				•	_		ļī
1,5 1	W FROM		N 87°44	00",1	145		ļ
A	isten Mon		D=67,54		(C)	——Q ,	4.0
		1,2,	D-61,54		书		ernsten Mon
00 (W)+1	ness chann	101			È	WĮ	Witness Chann
I hereby	certify th	at on the .	4th day of _	April			
, that I d:	id locate	the above of	corner which w	as evidence	ed	•	(
Alum.	HWY.	Cap			Aur	14 278-	94 56.614
		I further of	certify that t	o perpetua	te MA	ok 3-28-	
ocation of	f such cor	mer I did,	at the exact	location		01 01/2-17 - 6	ا جو ا
or, place	a permane	nt marker o	consisting of		DK 1	210-04 =	ِ گک
				Tipe	SOK O	210-04 =	5.5
lich d		; I furthe	r certify that				
risn 🔁 r	ererences	or witness	monuments con	sisting		-	اُدُ
- ISER	isten 1	MONGMA	ents whe			CE AI	
		1000003 -	- ' N	12rkers	0	SEAL	i
		rocated a	s shown above			·	1
	•			* .			
Signature Per	ristared Land	Cumuman	Registro	tion No	Title		

s --

e de la companya de l .

CORNER NO. ADAMS COUNTY SECTION Survey Monument Record 20 **TOWN** TYPE OF MONUMENT: Aluminum highway cap 7 RANGE STATE PLANE COORDINATES: N. E. ELEVATION — M.S.L. DATUM: . THETA ANGLE: . 45 FIELD BOOK: ____ PAGE BASIS FOR MONUMENT LOCATION (Use reverse side if necessary) LOCATION Show info such as: History of corner, with reference to Vol. and pg, dates, surveyor; exact description of monument replaced; if location computed, by taped or EDM traverse; landowner (Indicated by 'X') SEAL: remarks, etc. Set on a straight line between the S4 and SW corners of section 33-21-7 and at the distance west from the ANTHONY B. S4 corner as called for in the original notes. KIEDROWSKI Could find no evidence of the corner. S-878 Wisconsin Rapids, TIES & MON. O.K. 3-23-79 D.W. - P.N. SEE ATTACHED PAGE ALSO 4-4-91 CERTIFIED CORRECT: Figure 3 Calor Registered Land Surveyor DATE: 11/12/76 TIE SKETCH (Show at least four ties) PORTAGE CO. POWER

S.T.H. "73"

S.T.H. "73"

Sty 33-21-7

Sty 33-21-7

RIOW

CHANNEL
IRON

ADAM 5 CO. 15"

WHITE

(BT) PINE