

PUBLIC LAND SURVEY MONUMENT RECORD

TYPE OF MONUMENT: HARRISON
ADAMS COUNTY COORDINATES, NAD 83 (2007)

N. 320807.858

E. 580462.904


ELEVATION- DATUM

FIELD WORK DATE: 12/29/2016

BASIS FOR MONUMENT LOCATION


1978 - PLS 878 NO EVIDENCE OF PREVIOUS MONUMENTATION OR RECORDS OF ANY RESURVEYS.
SET HARRISON AT EQUIDISTANT BETWEEN ADJACENT SECTION CORNERS IN SECTION 2, AND ON LINE BETWEEN THE S1/4 AND SE CORNERS OF SECTION 35-21-7.

2017 - PLS 2994 FOUND EXISTING HARRISON AND 3 WITNESS TREES. THE HARRISON AGREES WITH EXISTING WITNESS TREES.
ACCEPTED HARRISON AND SET 4 NEW TIES.

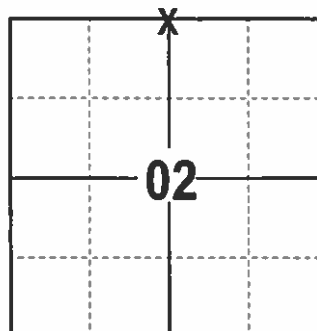

LOCATION
(INDICATE CORNER BY "X")

SEAL:

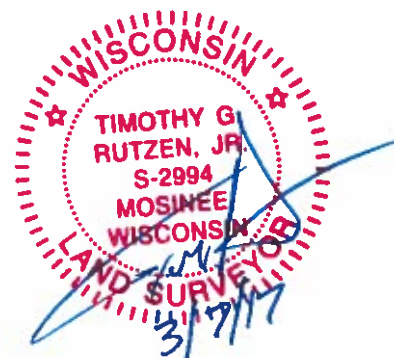



DATA SHOWN HERE ON THIS TIE SHEET IS CORRECT AND COMPLETE TO THE BEST OF MY KNOWLEDGE AND BELIEF.

PROFESSIONAL LAND SURVEYOR

DATE 3/7/17

- TIE SKETCH

NOTE: THERE IS REMNANTS OF FENCE 8± FEET SOUTH OF THE SECTION LINE

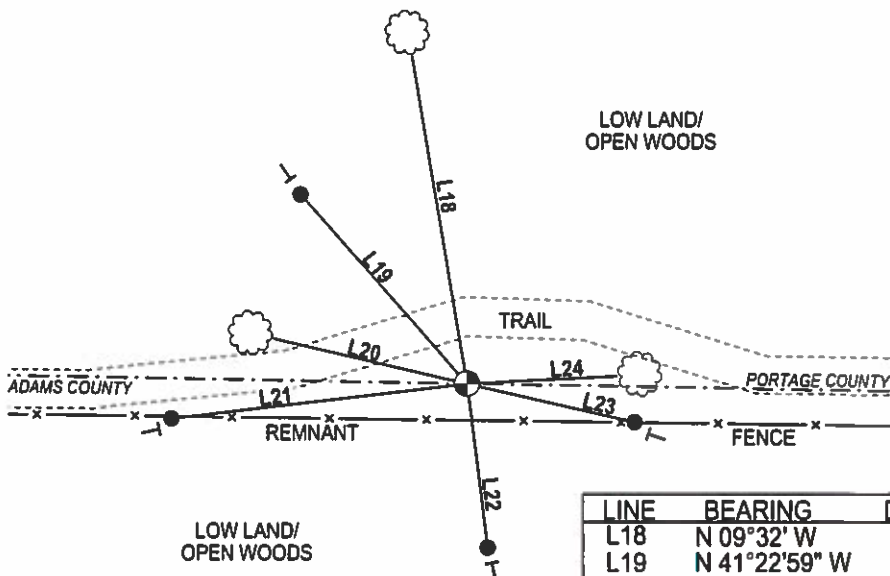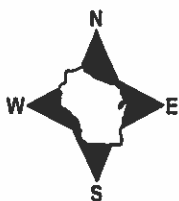


- 3/4" X 18" IRON REBAR SET, 1.50#/FT
- ⊙ HARRISON FOUND
- VINYL "T" POST
- ☁ WITNESS TREE FOUND

LINE	BEARING	DISTANCE
L18	N 09°32' W	74.5'±
L19	N 41°22'59" W	52.50'
L20	N 76°54' W	47.5'±
L21	S 83°20'42" W	62.27'
L22	S 07°00'20" E	34.31'
L23	S 77°09'37" E	35.85'
L24	N 87°06' E	37.0'±

Government Land Corner Certificate

ADAMS County
 TYPE OF MONUMENT: HARRISON
 STATE PLANE COORDINATES: N _____
 E _____
 ELEVATION — M.S.L. DATUM: _____
 THETA ANGLE: _____
 FIELD BOOK: 60 PAGE 55
 DRAWN BY: SCOTT SORENSEN

CORNER NO. 10
 SECTION 2
 TOWN 20
 RANGE 7

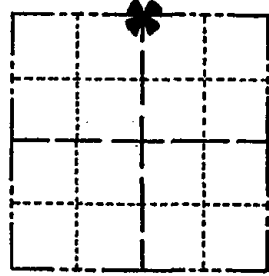

LOCATION
(Indicated by 'X')

BASIS FOR MONUMENT LOCATION

Show info such as: History of corner, with reference to Vol. and pg., dates, surveyor; exact description of monument replaced; if location computed, by taped or EDM traverse; landowner remarks, etc. (Use reverse side if necessary)

Set equidistant between adjacent section corners in Section 2 and on line between S $\frac{1}{4}$ corner of Section 35-21-7 and ^NSE corner of Section 35-21-7. No evidence of previous monumentation found and no records of any resurveys.

SEAL:




DATA SHOWN HERE ON CERTIFIED CORRECT:

Anthony B. Kiedrowski
 Registered Land Surveyor

DATE: 6/6/78

TIE SKETCH

Show at least four ties, also fence lines, roads, topo, size and type of witness trees and if off road - best way to arrive at corner.

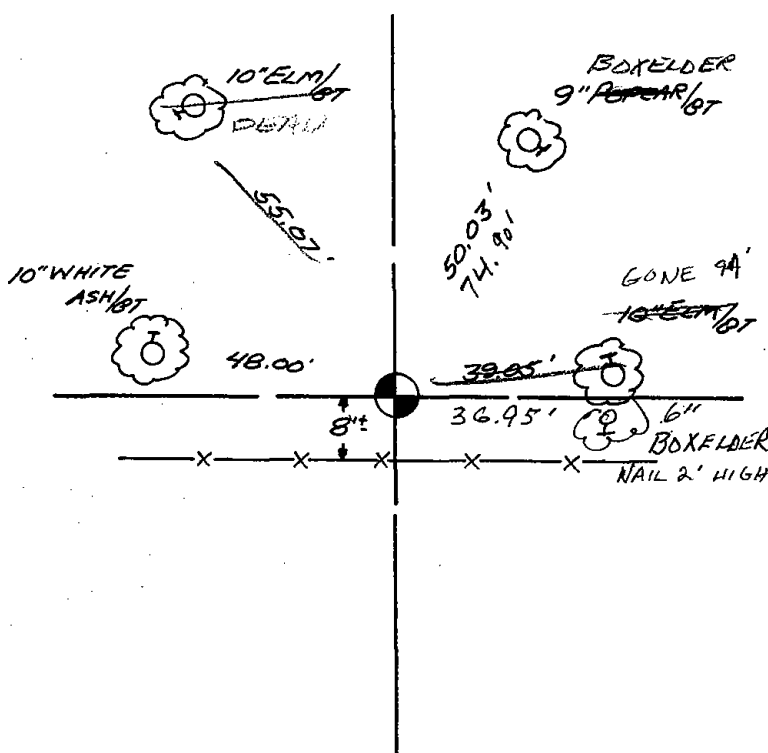

MAINTENANCE RECORD

Date	Init.	Remarks
6-14-94	JG-CR	1-GONE, 1-NEW TIE
3-2-99	JG-SS	1-GONE, 1-NEW
9-13-09	SS	OK - STEEL POST N & S

