SECTION

OT ADAMS COUNTY

COUNTY CORNER NO: 12

ROMPORTOL ID: 42007019020

PUBLIC LAND SURVEY MONUMENT RECORD

HARRISON TYPE OF MONUMENT: ADAMS COUNTY COORDINATES, NAD 83 (2007)

N. 320713.637

E. 585735.925

DATUM - - -


12/28/2016 FIELD WORK DATE:

BASIS FOR MONUMENT LOCATION

1982 - PLS 878 NO EVIDENCE OF THIS CORNER HAVING EVER BEING SET.

SET HARRISON AT EQUIDISTANT BETWEEN THE NE AND NW CORNER OF SECTION 1, AND ON LINE BETWEEN THE SE AND S1/4 **CORNERS OF 36-21-7.**

2017 - PLS 2994 FOUND EXISTING HARRISON 12"± BELOW THE SURFACE, FOUND 1 EXISTING WITNESS TREE. HARRISON FIT WELL WITH THE 1 WITNESS TREE. ACCEPTED HARRISON AND SET 4 NEW TIES.

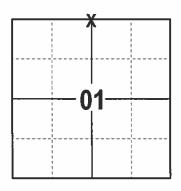

LOCATION (INDICATE CORNER BY "X")

SEAL:




DATA SHOWN HERE ON THIS TIE SHEET IS CORRECT AND COMPLETE TO THE BEST OF MY KNOWLEDGE AND BELIEF.

PROFESSIONAL LAND SURVEYOR

DATE_

- TIE SKETCH

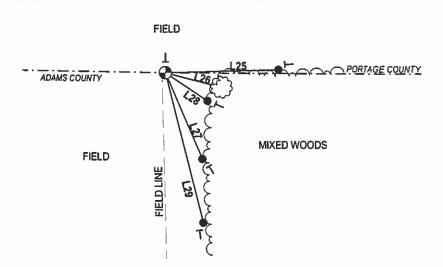

3/4" X 18" IRON REBAR SET, 1.50#/FT HARRISON FOUND VINYL "T" POST WITNESS TREE FOUND

	LINE	BEARING	DISTANCE
Γ	L25	N 88°32'40" E	47.13'
ı	L26	S 75°13' E	26.0'±
ı	L28	S 56°08'58" E	21.09'
ı	L27	S 23°10'41" E	39.10'
L	L29	S 14°08'10" E	64,33'

Government Land Corner Certificate CORNER NO. _ 12 ADAMS County SECTION TYPE OF MONUMENT: HARRISON 20 **TOWN** STATE PLANE COORDINATES: **RANGE** ELEVATION — M.S.L. DATUM: _ THETA ANGLE: FIELD BOOK: __88 _ PAGE 129 DRAWN BY: ____ 5.J.H. BASIS FOR MONUMENT LOCATION ANTHONY B. KIEDROWSKI S-878 Wisconsin Rapids. Wis. Show info such as: History of corner, with reference to Vol. and pg., dates, surveyor; exact description of monument replaced; if location computed, by taped or EDM traverse; landowner remarks, etc. (Use reverse side if necessary) SEAL: No evidence of this corner having ever been set. Set corner equidistant between the NE corner of Section 1 and the NW corner of Section 1, and on line between the SE corner of 36-21-7 and the \$\frac{1}{2}\$ corner of 36-21-7. 0k 5-2-84 SS-DK 2- CONE NOTHING AVAILABLE 3-28-94 56-6R OK 2-22-99-5G NEW 9-01-04 55 REMAINING THES 4-13-09 55 DATA SHOWN HERE ON CERTIFIED CORRECT: Anthony B. Keesl Registered Land Surveyor DATE: 5-25-82 TIE SKETCH Show at least four ties, also fence lines, roads, topo, size and type of witness trees' and if off road - best way to arrive at corner. S'BIK E 04K 04 26.5 GRADE

MAINTENANCE RECORD

DATE	BY WHOM	REMARKS
-		