01 SECTION 20 TOWN 07 RANGE

ADAMS COUNTY

COUNTY CORNER NO: 13

ROMPORTOL ID: 42007019000

PUBLIC LAND SURVEY MONUMENT RECORD

TYPE OF MONUMENT: HARRISON

ADAMS COUNTY COORDINATES, NAD 83 (2007)

N. 320689.161

E. 588392.182


ELEVATION- — DATUM — — —

FIELD WORK DATE: 1/3/2017

BASIS FOR MONUMENT LOCATION

1982 - PLS 878 SEARCHED FOR BEARING TREES AND RESURVEYS OF RECORD AND FOUND NONE. SET A HARRISON ON LINE BETWEEN THE S1/4 OF SECTION 31, T21N, R8E AND THE SE CORNER OF SECTION 31, T21N, R8E AT THE ORIGINAL GOVERNMENT DISTANCE OF 204.6 FEET.

2017 - PLS 2994 FOUND EXISTING HARRISON, 2 EXISTING TIES AND 1 WITNESS TREE. THE HARRISON AGREES WITH EXISTING TIES AND WITNESS TREE. THE HARRISON AGREES WITH THE EXISTING TIES AND WITNESS TREE. ACCEPTED HARRISON AND SET 2 NEW TIES.

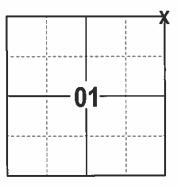

LOCATION (INDICATE CORNER BY "X")


TIMOTHY P.
RUTZEN, JR.
S-299
MOSINEE
WISCONSIL

DATA SHOWN HERE ON THIS TIE SHEET IS CORRECT AND COMPLETE TO THE BEST OF MY KNOWLEDGE AND BELIEF.

PROFESSIONAL LAND SURVEYOR

DATE 29/17

- TIE SKETCH

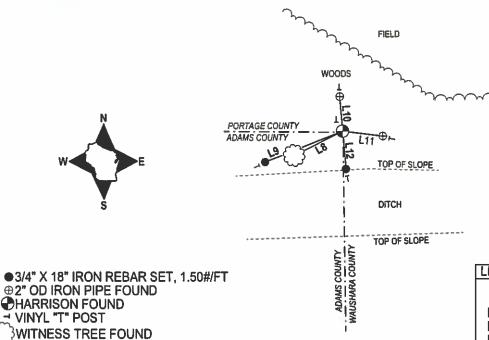

	7-75-	
LINE	BEARING	DISTANCE
L8	S 63°16 W	22.5'±
L9	S 68°32'52" W	34.90'
L10	N 04°42'22" W	14.41'
L11	S 83°04'35" E	16.82'
L12	S 04°51'31" F	15.79'

Government Land C	orner Certificate		/ 3
ADAMS	County	CORNER NO	13
TYPE OF MONUMENT: HA		SECTION .	
STATE PLANE COORDINATES:	: N		20
	F	RANGE	<u> </u>
ELEVATION — M.S.L. DATUMENTHETA ANGLE:			$\overrightarrow{\Lambda}$
FIELD BOOK: 88			
DRAWN BY: S.J. H.			
BASIS FOR MONUMENT I	LOCATION		
Show info such as: History of corne and pg., dates, surveyor; exact d	er, with reference to Vol.		
replaced; if location computed, by landowner remarks, etc. (Use reverse	taped or EDM traverse:	LOCATION (Indicated by 'X')	
		SEAL:	
Set corner on line beta Section 31-21-8 and the	ween the S4 corner of	MINISTER	L a
	vernment distance (204.6').	SHIPPING CON	No. of the last of
Searched for bearing t	rees, none remain. No	Sail N	
resurveys of record.		ANTHONY B	2 24
Ok 5-2-84 SS-DK		S-878 Wisconsin Rapid	□ ☆豊
2-NEW TIES 3-28-	Ga = .	Wis.	
3-2-99- JG-SS - 0		A Sammer	E Jack
9-01-04 OK-55 4-13-09 AK-55	× ·	SUR	11919.
4-13-09 88-55		DATA SHOWN HERE ON CERTIFIED CORRECT:	
			_0
		Registered Land Surveyor	C. C. C. C.
		DATE: 5-8-82	
			·
TIE SKETCH			
Show at least four ties, also fence l and type of witness trees' and if o	lines, roads, topo, size off road - best way to	-1D	
arrive at corner.	22 pinels []	ECE	Access
	XX '	/	4
	_	all /	
	· white s	and cvo	
		"White PinelBT /	
	+ <3.18.	6 White sign	
		16.81' = 4'+	·
	OOWN X 24 65 X	X WINFERCE T	
	20" BIK Oak	1	
	20 BIR DAR BT		
	1		
	FIE	LD	
	7 , 5		

MAINTENANCE RECORD

DATE	BY WHOM	REMARKS
-		
	-	