

02
SECTION

20
TOWN

07
RANGE

ADAMS COUNTY

COUNTY CORNER NO: 19

ROMPORTOL ID: 42007022000

PUBLIC LAND SURVEY MONUMENT RECORD

TYPE OF MONUMENT: HARRISON (BROKEN-TOP)

ADAMS COUNTY COORDINATES, NAD 83 (2007)

N. 316986.998

E. 583148.293


ELEVATION- - - - - DATUM - - - - -

FIELD WORK DATE: 03/03/2020

BASIS FOR MONUMENT LOCATION

1982 - PLS 878 SET MONUMENT AT CORNER OF ANCIENT FENCE NORTH AND WEST, AS THIS FENCE CORNER FITS PRORATED DISTANCE TO THE NW CORNER OF SECTION 1 WITHIN A FOOT. NO RESURVEYS OF RECORD. SEARCHED FOR BEARING TREES, NONE REMAIN.

2020 - PLS 2675 FOUND A HARRISON (BROKEN-TOP) MONUMENT 6"± BLOW THE GROUND SURFACE AND 3 WITNESS TREES. THE MONUMENT AGREES WITH ALL 3 WITNESS TREES. ACCEPTED THE HARRISON (BROKEN-TOP) MONUMENT AS THE CORNER LOCATION. SET 4 NEW TIES AND MEASURED TO THE EXISTING WITNESS TREES.

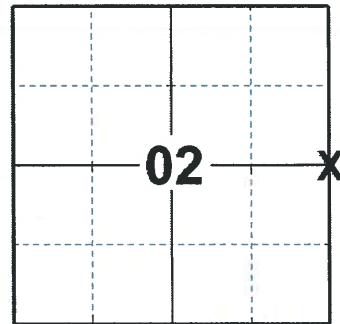

LOCATION

(INDICATE CORNER BY "X")

SEAL:





DATA SHOWN HERE ON THIS TIE SHEET IS CORRECT AND COMPLETE TO THE BEST OF MY KNOWLEDGE AND BELIEF.

PROFESSIONAL LAND SURVEYOR

DATE 3/25/2020

TIE SKETCH

NOTE: THE WITNESS TREE TO THE SOUTHWEST IS S55°W 5'± OF THE CORNER.

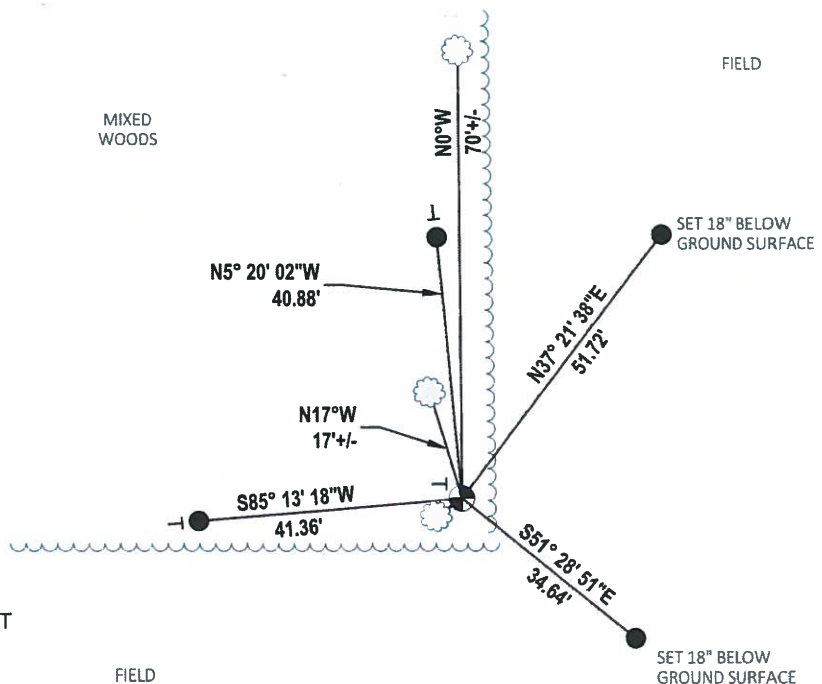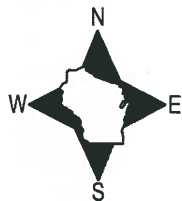


- SET 3/4" x 18" IRON REBAR, 1.50#/FT
- ⊕ FOUND HARRISON (BROKEN-TOP) MONUMENT
- ⊥ VINYL "T" POST
- ☁ WITNESS TREE

Government Land Corner Certificate

ADAMS County
 TYPE OF MONUMENT: HARRISON
 STATE PLANE COORDINATES: N _____
 E _____
 ELEVATION — M.S.L. DATUM: _____
 THETA ANGLE: _____
 FIELD BOOK: 88 PAGE 121
 DRAWN BY: S.J.H.

CORNER NO. 19
 SECTION 1
 TOWN 20
 RANGE 7

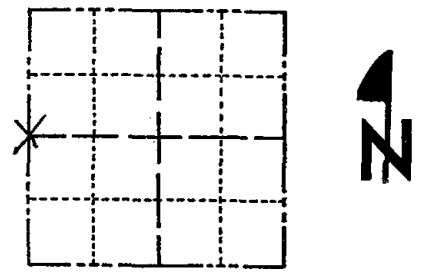

LOCATION
 (Indicated by 'X')

BASIS FOR MONUMENT LOCATION

Show info such as: History of corner, with reference to Vol. and pg., dates, surveyor; exact description of monument replaced; if location computed, by taped or EDM traverse; landowner remarks, etc. (Use reverse side if necessary)

Set monument at corner of ancient fence North and West, as this fence corner fits prorated distance to the NW corner of Section 1 within a foot. No resurveys of record. Searched for bearing trees, none remain.

OK 5-2-84 DK-SS

SEAL:



DATA SHOWN HERE ON
 CERTIFIED CORRECT:

Anthony B. Kiedrowski
 Registered Land Surveyor

DATE: 5-4-82

TIE SKETCH

Show at least four ties, also fence lines, roads, topo, size and type of witness trees and if off road - best way to arrive at corner.

