# OT ADAMS COUNTY

COUNTY CORNER NO: 20

ROMPORTOL ID: 42007012000

# PUBLIC LAND SURVEY MONUMENT RECORD

HARRISON WITH TOP BROKE OFF TYPE OF MONUMENT: ADAMS COUNTY COORDINATES, NAD 83 (2007)

N. <u>317048.961</u>

E. 588431.702


DATUM\_ - - -

FIELD WORK DATE: 12/28/2016

#### BASIS FOR MONUMENT LOCATION

1982 - PLS 878 DID NOT FIND ANY REMAINS OF ANY REMONUMENTATON AND FOUND NO RESURVEYS OF RECORD. SET A HARRISON ON LINE AT A PRORATED DISTANCE BETWEEN THE SE AND NE CORNERS OF SECTION 1.

2017 - PLS 2994 FOUND EXISTING HARRISON 10 INCHES BELOW THE SURFACE, 2 EXISTING TIES AND 2 WITNESS TREES. THE HARRISON AGREES WITH EXISTING TIES AND WITNESS TREES. ACCEPTED HARRISON AND SET 2 NEW TIES.

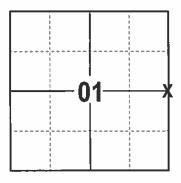

LOCATION (INDICATE CORNER BY "X")


SEAL: CON TIMOTHY G. RUTZEN, JR. S-2994 MOSINE WISCONS

DATA SHOWN HERE ON THIS TIE SHEET IS CORRECT AND COMPLETE TO THE BEST OF MY KNOWLEDGE AND BELIEF.

PROFESSIONAL LAND SURVEYOR

DATE

- TIE SKETCH

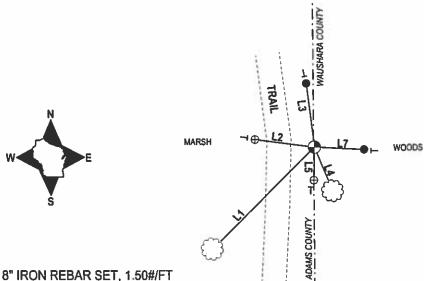

DISTANCE BEARING N 45°07' E 60.5'± L2 N 82°40'08" W 25.08' L3 N 07°13'27" W 26.67 L4 S 22°27' E 19.5'± L<sub>5</sub> S 01°14'06" W 13.73 S 87°19'14" E 20.77

●3/4" X 18" IRON REBAR SET, 1.50#/FT **#2" OD IRON PIPE WTH CAP FOUND** 

HARRISON FOUND VINYL "T" POST

WITNESS TREE FOUND

### **Government Land Corner Certificate** CORNER NO. . ADAMS County SECTION TYPE OF MONUMENT: HARRISON 20 TOWN STATE PLANE COORDINATES: RANGE ELEVATION — M.S.L. DATUM: . THETA ANGLE: \_ 88 FIELD BOOK: \_\_\_ PAGE \_ 5.J.H. DRAWN BY: \_\_\_\_ BASIS FOR MONUMENT LOCATION Show info such as: History of corner, with reference to Vol. and pg., dates, surveyor; exact description of monument replaced; if location computed, by taped or EDM traverse; landowner remarks, etc. (Use reverse side if necessary) LOCATION (Indicated by 'X') SEAL: Set corner on line at prorated distance between SE corner of Section 1 and NE corner of Section 1. No resurveys of record. Could find no remains of any remonumentation. ANTHONY B. **KIEDROWSKI** S-878 Wisconsin Rapids, Wis. DATA SHOWN HERE ON CERTIFIED CORRECT: And Surveyor Registered Land Surveyor DATE: \_ TIE SKETCH Show at least four ties, also fence lines, roads, topo, size and type of witness trees' and if off road - best way to W) arrive at corner. , 10" BASSWOOD/BT GIP/CAP 2"X 30"

FIEDD

## MAINTENANCE RECORD

DATE	BY WHOM	REMARKS
14 JUN 94	CE-39	2K
3-2-99	JG-55	OK
9-1-04	<b>55</b>	OK
4-13-09	SS	OK .
	*	