20 TOWN

OT RANGE ADAMS COUNTY COUNTY CORNER NO: 32

ROMPORTOL ID: 42007010020

PUBLIC LAND SURVEY MONUMENT RECORD

HARRISON (BROKEN-TOP) TYPE OF MONUMENT:

ADAMS COUNTY COORDINATES, NAD 83 (2007)

N 314371.391

E. 585809.279

ELEVATION-

DATUM


FIELD WORK DATE:

03/03/2020

BASIS FOR MONUMENT LOCATION

1982 - PLS 878 SET CORNER ON LINE BETWEEN THE SE CORNER OF SECTION 1 AND SW CORNER OF SECTION 1 OPPOSITE FENCE LINE TO THE SOUTH. IF CORNER PLACED EQUIDISTANT, IT WOULD FALL 20' EAST OF FENCE. HELD THE FENCE AS BEST AVAILABLE EVIDENCE. NO RESURVEYS OF RECORD. COULD FIND NO BEARING TREES OR ANY MONUMENT.

2020 - PLS 2675 FOUND HARRISON (BROKEN-TOP) 6"± BELOW THE GROUND AND 2 TIES. THE MONUMENT AGREES WITH BOTH TIES. ACCEPTED THE HARRISON (BROKEN-TOP) AS THE CORNER LOCATION. SET 2 NEW TIES AND MEASURED TO THE **EXISTING TIES.**

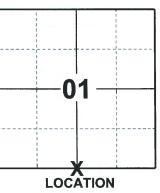

(INDICATE CORNER BY "X")



DATA SHOWN HERE ON THIS TIE SHEET IS CORRECT AND COMPLETE TO THE BEST OF MY KNOWLEDGE AND BELIEF.


PROFESSIONAL LAND SURVEYOR

2020 DATE

-TIE SKETCH

NOTE: THE CORNER LANDS IN AREA OF NO TILLAGE CROP LAND.



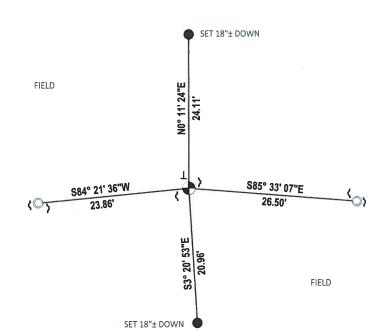

- SET 3/4" x 18" IRON REBAR, 1.50#/FT
 - FOUND 1-1/4" O.D. IRON PIPE
- FOUND HARRISON (BROKEN-TOP) MONUMENT
 - STEEL FENCE POST

ADAMSCounty	⊸ ∩
DI/DI/I	CORNER NO. 32
TYPE OF MONUMENT: HARRISON	SECTION /
STATE PLANE COORDINATES: N	TOWN
F	RANGE 7
ELEVATION M.S.L. DATUM:	
THETA ANGLE:	
FIELD BOOK: 88 PAGE 120 DRAWN BY: 5.J.H	
DRAWN BY: 3.3.7	_
DACIC FOR MONITIMENTS LOCATION	- IN
BASIS FOR MONUMENT LOCATION	
Show info such as: History of corner, with reference to Vol. and pg., dates, surveyor; exact description of monument replaced; if location computed, by taped or EDM traverse;	<u> </u>
replaced; if location computed, by taped or EDM traverse; landowner remarks, etc. (Use reverse side if necessary)	LOCATION (Indicated by 'X')
	SEAL:
Set corner on line between the SE corner of Section 1 and SW corner of Section 1 opposite	**************************************
fence line to the South. If corner placed	July 500 1 2 1/2
equidistant, it would fall 20' East of fence.	ARTH A
Held the fence as best available evidence. No resurveys of record. Could find no bearing	ANTHONY B. KIEDROWSKI
trees or any monument.	5. 878 ≦
•	Wisconsin Rapids, Wis.
1 gone Ok 5-2-84 DK-SS	
TOP 6" OF MONUMENT BROWN DET, THE SOR 2"X4" MODERN FOR WAYE LINE STALL BOME 494 JB-CR	DATA SHOWN HERE ON
OK 3-22-99 JG-JF	CERTIFIED CORRECT:
OK 4-13-09 SS	Registered Land Surveyor
	DATE: 5-8-82
TIE SKETCH	
Show at least four ties, also fence lines, roads, topo, size and type of witness trees' and if off road - best way to	
FO HAR & 2 PIPES - Fo. 2 STEEZ POSTS	38
A ALL MAIL EN MID-WAY BETWEEN	- 12/2/2018
EACH SET of POSTS - OK 9-01-54 FIEL	LD
premiser of 1921	- 40
	`
	26.52
2.5' 23.90	/"I.P.
	73,50 W/cap
2.5 x 23.90 x 1 1 1.P. w/cap 30.3> 10	33,60 W/ Cap
	33/2 XI.P.
χ (π.Ε. ω/caρ 30.3) (π. μ.	33/2 XI.P.
χ (π.Ε. ω/caρ 30.3) (π. μ.	33,50 Weap WISOP
	33/2 XI.P.

MAINTENANCE RECORD

DATE	BY WHOM	REMARKS
<u> </u>		
	;	