# OT RANGE ADAMS COUNTY COUNTY CORNER NO: 44 ROMPORTOL ID: 42007080020


## PUBLIC LAND SURVEY MONUMENT RECORD

**HARRISON** TYPE OF MONUMENT:\_ ADAMS COUNTY COORDINATES, NAD 83 (2007) N. **308956.441** E. 564746.517 ELEVATION-DATUM 02/18/2020 FIELD WORK DATE:


#### BASIS FOR MONUMENT LOCATION

1982 - PLS 1444 THIS CORNER WAS SET EQUIDISTANT AND ON LINE BETWEEN SECTION CORNERS. NO EVIDENCE OF THE ORIGINAL CORNER OR ANY RESURVEY CORNER.

2020 - PLS 2675 FOUND HARRISON MONUMENT 6"± BELOW THE GROUND AND 3 WITNESSES, THE MONUMENT AGREES WITH ALL 3 WITNESSES, ACCEPTED THE HARRISON AS THE CORNER LOCATION. SET 4 NEW TIES AND MEASURED TO THE EXISTING WITNESSES.

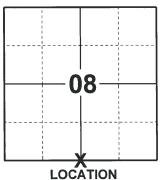

(INDICATE CORNER BY "X")

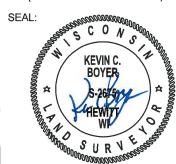

DATA SHOWN HERE ON THIS TIE SHEET IS CORRECT AND COMPLETE TO THE BEST OF MY KNOWLEDGE AND BELIEF.


PROFESSIONAL LAND SURVEYOR

#### -TIE SKETCH

NOTE: THE CORNER LANDS 22'± NORTH OF CTH "D".



- SET 3/4" x 18" IRON REBAR, 1,50#/FT
- FOUND HARRISON MONUMENT
- FOUND MAGNAIL IN FENCE POST
- → VINYL "T" POST

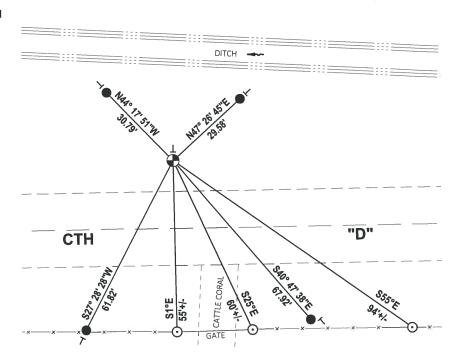

### **Government Land Corner Certificate** CORNER NO. ADAMS County 8 **SECTION** TYPE OF MONUMENT: HARRISON 20 **TOWN** STATE PLANE COORDINATES: N\_ **RANGE** E. ELEVATION — M.S.L. DATUM: THETA ANGLE: \_ 88 \_ PAGE \_*\_\_ 145* FIELD BOOK: \_\_ DRAWN BY: \_\_\_\_\_ 5.T.H BASIS FOR MONUMENT LOCATION Show info such as: History of corner, with reference to Vol. and pg., dates, surveyor; exact description of monument replaced; if location computed, by taped or EDM traverse; landowner remarks, etc. (Use reverse side if necessary) (Indicated by 'X') SEAL: MINISCONS NING This corner was set equidistant and on line between section corners. No evidence of the original corner or any resurvey corner. LANCE J. **HABECK** 0k 4-30-84 SS-DK **\$-1444** Stevens Point, Wis. DATA SHOWN HERE ON CERTIFIED CORRECT: Registered Land Surveyor DATE: TIE SKETCH Show at least four ties, also fence lines, roads, topo, size and type of witness trees' and if off road - best way to arrive at corner. I. P. set cap <u>C.T.H.</u>

O. Fence

post

CORA

125 +

## MAINTENANCE RECORD

DATE	BY WHOM	REMARKS
4-20-94	SS	0.K.
2-22-99 12-14-09	J6 J5-55 SS	O.K.
12-14-09	JS-55	OK.
10-08-09	55	OK!
	·	