OT RANGE ADAMS COUNTY COUNTY CORNER NO: 57 ROMPORTOL ID: 42007162000

PUBLIC LAND SURVEY MONUMENT RECORD

HARRISON TYPE OF MONUMENT: ADAMS COUNTY COORDINATES, NAD 83 (2007)

N. 306361.523

E. 572738.330


DATUM

FIELD WORK DATE: 02/24/2020


BASIS FOR MONUMENT LOCATION

1982 - PLS 1444 THIS CORNER WAS SET EQUIDISTANT AND ON LINE BETWEEN SECTION CORNERS. NO EVIDENCE OF THE ORIGINAL CORNER OR ANY RESURVEY CORNER.

2020 - PLS 2675 FOUND HARRISON 18"± BELOW THE SHOULDER AND DID NOT RECOVER ANY TIES OR WITNESSES. THE MONUMENT WAS VERIFIED TO BE ON A NEAR STRAIGHT LINE AND EQUIDISTANT BETWEEN THE NE AND SE CORNERS OF SECTION 16. ACCEPTED THE HARRISON MONUMENT AS THE BEST EVIDENCE OF THE CORNER LOCATION. SET 4 NEW TIES.

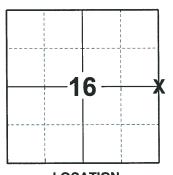

LOCATION (INDICATE CORNER BY "X")

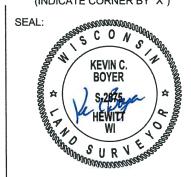


DATA SHOWN HERE ON THIS TIE SHEET IS CORRECT AND COMPLETE TO THE BEST OF MY KNOWLEDGE AND BELIEF.

PROFESSIONAL LAND SURVEYOR 2020

-TIE SKETCH

NOTE: THE CORNER LANDS 15.5'± WEST OF CTH 'W' CENTERLINE.



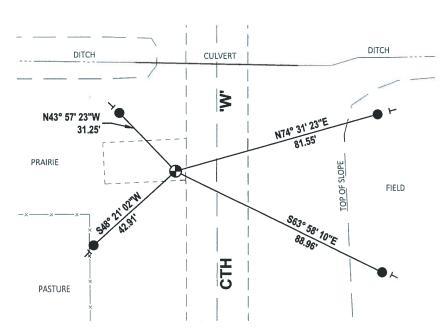

- SET 3/4" x 18" IRON REBAR, 1.50#/FT
- FOUND HARRISON MONUMENT
- VINYL "T" POST

Government Land Corner Certificate CORNER NO. ___57 ADAMS County **SECTION** TYPE OF MONUMENT: HARRISON 20 TOWN STATE PLANE COORDINATES: **RANGE** E_ ELEVATION -- M.S.L. DATUM: _ THETA ANGLE: __ 88 _ PAGE _/43 FIELD BOOK: ____ 5.7 H DRAWN BY: _____ BASIS FOR MONUMENT LOCATION Show info such as: History of corner, with reference to Vol. and pg., dates, surveyor; exact description of monument replaced; if location computed, by taped or EDM traverse; landowner remarks, etc. (Use reverse side if necessary) LOCATION LANCE J. HABECK SEAL: This corner was set equidistant and on line between section corners. No evidence of the original corner or any resurvey corner. Ok 4-30-84 SS-DK Stevens Point, Wis. DATA SHOWN HERE ON CERTIFIED CORRECT: Registered Land Surveyor DATE: . TIE SKETCH Show at least four ties, also fence lines, roads, topo, size and type of witness trees' and if off road - best way to 1000 arrive at corner. Bloc Kiel 1"XZ4" I.P. 4 cap set

HUNTER WALKING TRAIL

SIGN POST

MAINTENANCE RECORD

DATE	BY WHOM	REMARKS
4-21-94	7G-55	1 TIE GONE-SET Z NEW
2-22-99	JE	OK
12-10-04	55	OK .
10-67-09	55	Z TIES REMAIN - HAR + 14" DEEP
ļ		