OT RANGE ADAMS COUNTY CORNER NO: 59 ROMPORTOL ID: 42007142000

PUBLIC LAND SURVEY MONUMENT RECORD

SURVEY NAIL TYPE OF MONUMENT: ADAMS COUNTY COORDINATES, NAD 83 (2007)

N. 306401.193

E. 583330.586

ELEVATION- - - -DATUM


FIELD WORK DATE: 02/24/2020

BASIS FOR MONUMENT LOCATION


1973 - PLS 878 EXCAVATED WITH BACKHOE. FOUND REMNANT OF DRIVEN CEDAR POST. ALSO FOUND HOLE FROM A DUG IN POST. ALSO FOUND A RAILROAD SPIKE IN BLACKTOP 0.1' NORTH AND 0.9' EAST OF DRIVEN CEDAR POST. MONUMENTED LOCATION OF DRIVEN WOOD CEDAR POST AND CONFIRMED LOCATION BY A TRAVERSE ENTIRE SECTION.

2013 - PLS 1478 FOUND HARRISON IN PLACE 8-16-13 AND REMOVED BECAUSE OF ROAD CONSTRUCTION AND SET IRON RODS FOR NEW TIES. SET MAG NAIL IN PLACE OF HARRISON ON 10-24-2013 AFTER ROAD CONSTRUCTION COMPLETED.

2020 - PLS 2675 FOUND SURVEY NAIL IN THE ROAD SURFACE AND 4 TIES (NW AND SW HAVE BEEN DISTURBED). THE MONUMENT AGREES WITH THE NE AND SE TIES. ACCEPTED THE SURVEY NAIL AS THE CORNER LOCATION. STRAIGHTENED THE NW AND SW TIES AND MEASURED TO ALL 4 EXISTING TIES.

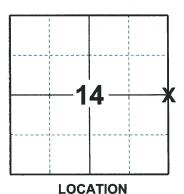

(INDICATE CORNER BY "X")

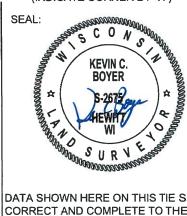

DATA SHOWN HERE ON THIS TIE SHEET IS CORRECT AND COMPLETE TO THE BEST OF MY KNOWLEDGE AND BELIEF.


PROFESSIONAL LAND SURVEYOR

 
-TIE SKETCH

NOTE: THE CORNER LANDS 1.5'± WEST OF CTH 'G' CENTERLINE.



FIELD

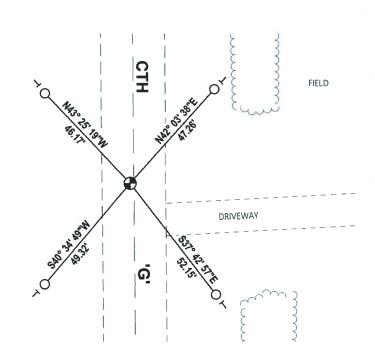



FOUND SURVEY NAIL MONUMENT

VINYL "T" POST

U.S PUBLIC LAND SURVEY MONUMENT RECORD CORNER NO. 59 ADAMS COUNTY, WISCONSIN

SECTION 13 TOWN 20N RANGE 7E


TYPE OF MONUMENT: Mag Nail

ADAMS COUNTY COORDINATES: N: 306,401.127 ft

E: 583,330.684 ft

ELEVATION _ MSL DATUM: NOT APPLICABLE

THETA ANGLE: NOT APPLICABLE FIELD BOOK: 108, PAGE 46 DRAWN BY: ERIC SCHOOT

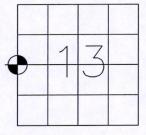

LOCATION


BASIS FOR MONUMENT LOCATION

Show info such as: History of corner, with reference to Vol. and pg., dates, surveyor; exact description of monument replaced if location computed, by taped or EDM traverse, landowner remarks, etc.

Excavated with backhoe. Found remnant of driven cedar post. Also found hole from a dug in post. Also found a railroad spike in blacktop 0.1' north and 0.9' east of driven cedar post. Monumented location of driven wood cedar post and confirmed location by a traverse entire section.


- Anthony Kiedrowski 9-18-73

Found Harrison in place 8-16-13 and removed because of road Construction and set Iron Rods for new ties. Set mag nail in place of Harrison on 10-24-13 after road Construction completed.

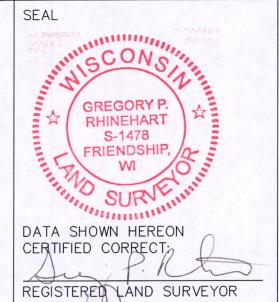

DATE: 2 December, 2013

TIE SKETCH: 1 Inch = 30 Feet

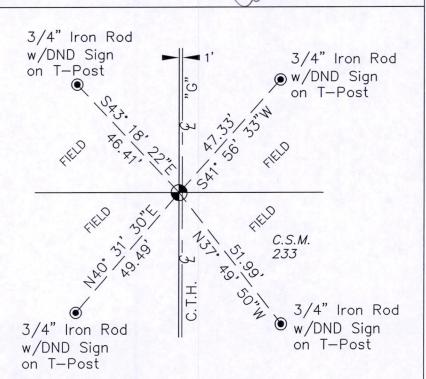

		CE RECORD
DATE	INIT.	REMARKS