OT RANGE ADAMS COUNTY C

PUBLIC LAND SURVEY MONUMENT RECORD

HARRISON TYPE OF MONUMENT: ADAMS COUNTY COORDINATES, NAD 83 (2007) N. 303676.450 E. 564732.057 ELEVATION-___- - ---DATUM

03/09/2020

BASIS FOR MONUMENT LOCATION

FIELD WORK DATE:_

1981 - PLS 878 NO RECORD OF ANY RESURVEYS. DID NOT EXCAVATE SINCE THERE IS NO OCCUPATION EVIDENCE AS TO WHERE TO DIG, AND ROAD IS IN A DEEP FILL, BEING ON TOP OF THE DITCH BANK, CORNER IS SET ON LINE AND EQUIDISTANT BETWEEN SECTION CORNERS.

2020 - PLS 2675 FOUND HARRISON MONUMENT 8"± BELOW THE ROAD SURFACE AND 3 TIES (NORTH TIE DISTURBED). THE MONUMENT AGREES WITH BOTH GOOD TIES. ACCEPTED THE HARRISON MONUMENT AS THE CORNER LOCATION. SET 1 NEW TIE, STRAIGHTENED THE DISTURBED TIE, AND MEASURED TO THE EXISTING TIES.



(INDICATE CORNER BY "X")




DATA SHOWN HERE ON THIS TIE SHEET IS CORRECT AND COMPLETE TO THE BEST OF MY KNOWLEDGE AND BELIEF.

PROFESSIONAL LAND SURVEYOR 3/25


-TIE SKETCH

NOTE: THE CORNER LANDS 2.4'± SOUTH OF APACHE AVE. CENTERLINE



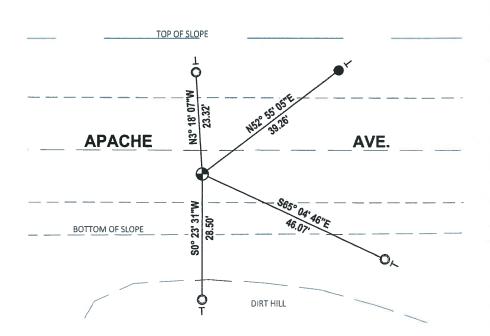

 - SET 3/4" x 18" IRON REBAR, 1.50#/FT
- FOUND 1-1/4" O.D. IRON PIPE
 - FOUND HARRISON MONUMENT
- VINYL "T" POST



		CORN	IER NO
ADAMS		SECT	ION
	9RR1500	TOW	V <u>20</u>
THE TENTE COOKDIVATES	E	RANG	E
LEVATION — M.S.L. DATU	M:	<u></u>	X -
THETA ANGLE:			
	PAGE 79	 	
DRAWN BY: 4 COOM	2 B S		+ NI
SASIS FOR MONUMENT 1	LOCATION		IN
			
how info such as: History of corner nd pg., dates, surveyor; exact d	escription of monument	I.O.C.A.	Lil
eplaced; if location computed, by andowner remarks, etc. (Use rever	raped or EDIM traverse; se side if necessary)	LOCA' (Indicated	
		SEAL:	411111111111111111111111111111111111111
	veys. Did not excavate	STRIPTION AND AND AND AND AND AND AND AND AND AN	CONSININ
since there is no occu	pation evidence as to	and Miles	A STATE OF THE PARTY OF THE PAR
where to dig, and road being on top of the di	tch bank. Corner is set	Z / A	NTHONY B.
	t between section corners.	KI KI	IEDROWSKI S-878
4 00 04 CC DV		WI WI	sconsin Rapids, 💢 🕏
4-20-84 SS-DK			Wis.
c 4/15/94 JG-5	• •	4,0	The state of the s
2-19-99- JC	·	******	SURVINI
2 8-26-04 55 03-62-09 55		DATA SHOWN H	EDE ON
		CERTIFIED CORRE	CT:
		Andrew	BKachows
		Registered Land Surv 11/4/8	eyor 3]
		DATE:	·-
TIE SKETCH		1.	
	lines, roads, tono, size	<u> </u>	
Show at least four ties, also fence l and type of witness trees' and if o		★ 61	
rrive at corner.	-× T^5	Ž'± 9	
<u> </u>	OITCH	cy	
	1 101	4" I.P. W/CAP	
APA	ACHE N &		AUE.
	~ ~ ~ ~ ~ ~ ~ ~ ~ ~ ~ ~ ~ ~ ~ ~ ~ ~ ~	80	
	. 6.	5/ 6g.	
	102.00, 2.55	6.3.	
	102 John	OF BANK	
		CAP	"XZ4" I.P. WCAP
		43.04'-	VORTH SIDE
		,	<u>+</u>
	30" COTTON WOOD/		FRANK-I
	l_{BT}	×	PRANK-L NIOWAY UP
	BT X FE		_

MAINTENANCE RECORD

DATE	BY WHOM	REMARKS
		·
l <u></u> -		
1		