

16
SECTION

20
TOWN

07
RANGE

ADAMS COUNTY

COUNTY CORNER NO: 66

ROMPORTOL ID: 42007160020

PUBLIC LAND SURVEY MONUMENT RECORD

TYPE OF MONUMENT: HARRISON (BROKEN-TOP)
ADAMS COUNTY COORDINATES, NAD 83 (2007)

N. 303703.161

E. 570054.861


ELEVATION- DATUM

FIELD WORK DATE: 03/09/2020

BASIS FOR MONUMENT LOCATION

1981 - PLS 878 NO RESURVEYS ON RECORD. DID NOT EXCAVATE SINCE THERE WAS ABSOLUTELY NO EVIDENCE TO INDICATE WHERE TO DIG, AND IT APPEARED THE CORNER FELL OFF ROAD. CORNER IS SET ON LINE AND EQUIDISTANT BETWEEN SECTION CORNERS.


2020 - PLS 2675 FOUND HARRISON (BROKEN-TOP) 6"± BELOW THE GROUND, 1 TIE, AND 1 WITNESS. THE MONUMENT AGREES WITH THE TIE AND WITNESS. ACCEPTED THE HARRISON (BROKEN-TOP) AS THE CORNER LOCATION. SET 3 NEW TIES AND MEASURED TO THE EXISTING TIE AND WITNESS.

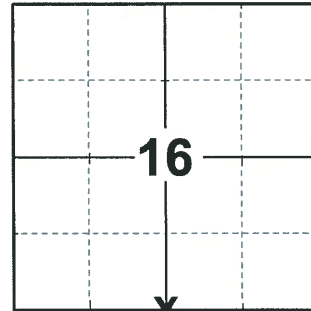

LOCATION

(INDICATE CORNER BY "X")

SEAL:

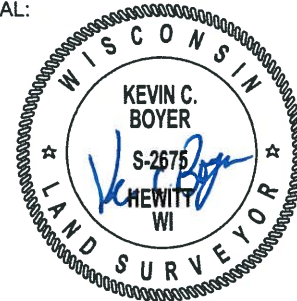


DATA SHOWN HERE ON THIS TIE SHEET IS CORRECT AND COMPLETE TO THE BEST OF MY KNOWLEDGE AND BELIEF.

PROFESSIONAL LAND SURVEYOR


DATE 3/25/2020

- TIE SKETCH

NOTE: THE CORNER LANDS 14.1'± SOUTH OF APACHE AVE. CENTERLINE.

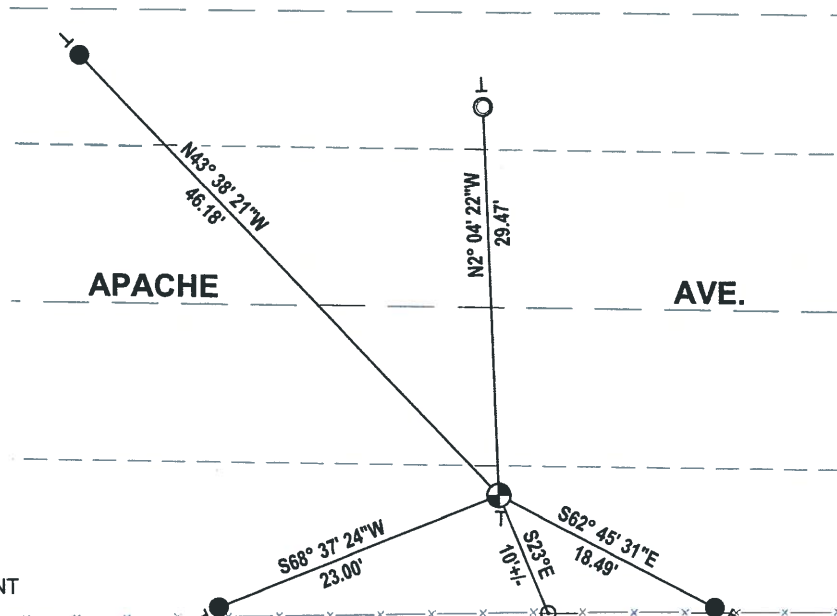

 
- SET 3/4" x 18" IRON REBAR, 1.50#/FT
- ⊙ FOUND 1-1/4" O.D. IRON PIPE
- ⊕ FOUND HARRISON (BROKEN-TOP) MONUMENT
- ⊥ VINYL "T" POST
- ⊙ FENCE POST



Government Land Corner Certificate

ADAMS County
 TYPE OF MONUMENT: HARRISON
 STATE PLANE COORDINATES: N _____
 E _____
 ELEVATION — M.S.L. DATUM: _____
 THETA ANGLE: _____
 FIELD BOOK: 88 PAGE 82
 DRAWN BY: L. COOMBS

CORNER NO. 60
 SECTION 21
 TOWN 20
 RANGE 7

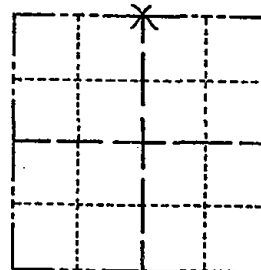

BASIS FOR MONUMENT LOCATION

Show info such as: History of corner, with reference to Vol. and pg., dates, surveyor; exact description of monument replaced; if location computed, by taped or EDM traverse; landowner remarks, etc. (Use reverse side if necessary)

No resurveys on record. Did not excavate since there was absolutely no evidence to indicate where to dig, and it appeared the corner fell off road. Corner is set on line and equidistant between section corners.

1 gone top 12 inches broken off no new taken
4-20-84 DK-SS

1 GONE - 1 NEW 4-15-94 JG-SS
 OK 2-19-99-JC
 OK 8-26-04 SS

SEAL:



DATA SHOWN HERE ON CERTIFIED CORRECT:

Anthony B. Kiedrowski
 Registered Land Surveyor
 11/4/81

DATE: _____

TIE SKETCH

Show at least four ties, also fence lines, roads, topo, size and type of witness trees and if off road - best way to arrive at corner.

