

PUBLIC LAND SURVEY MONUMENT RECORD

TYPE OF MONUMENT: HARRISON
ADAMS COUNTY COORDINATES, NAD 83 (2007)

N. 301019.189
E. 562027.413


ELEVATION- - - - DATUM - - - -

FIELD WORK DATE: 02/27/2020

BASIS FOR MONUMENT LOCATION


1981 - PLS 878 EXCAVATED WITH BACKHOE, FOUND NOTHING, EXCEPT WHEN DIGGING IN THE WEST SHOULDER, FOUND SOME WIRE REMNANTS OF A FENCE THAT RAN WEST FROM HERE. CORNER IS SET ON LINE AND EQUIDISTANT BETWEEN SECTION CORNERS.

2020 - PLS 2675 FOUND HARRISON 6"± BELOW THE ROAD SURFACE AND 1 TIE. THE MONUMENT AGREES WITH THE TIE. ACCEPTED THE HARRISON AS THE CORNER LOCATION. SET 4 NEW TIES AND MEASURED TO THE EXISTING TIE.

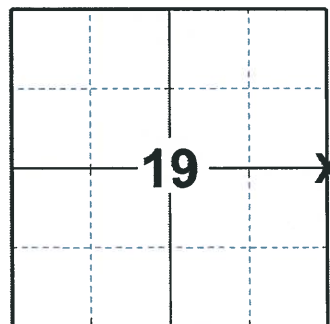

LOCATION
(INDICATE CORNER BY "X")

SEAL:

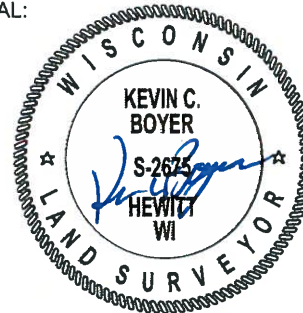

DATA SHOWN HERE ON THIS TIE SHEET IS CORRECT AND COMPLETE TO THE BEST OF MY KNOWLEDGE AND BELIEF.


PROFESSIONAL LAND SURVEYOR

DATE 3/25/2020

TIE SKETCH

NOTE: THE MONUMENT LANDS 10'± WEST OF 6TH AVE. CENTERLINE.

NOTE: THE FOUND IRON ROD IS 12± BELOW THE ROAD.

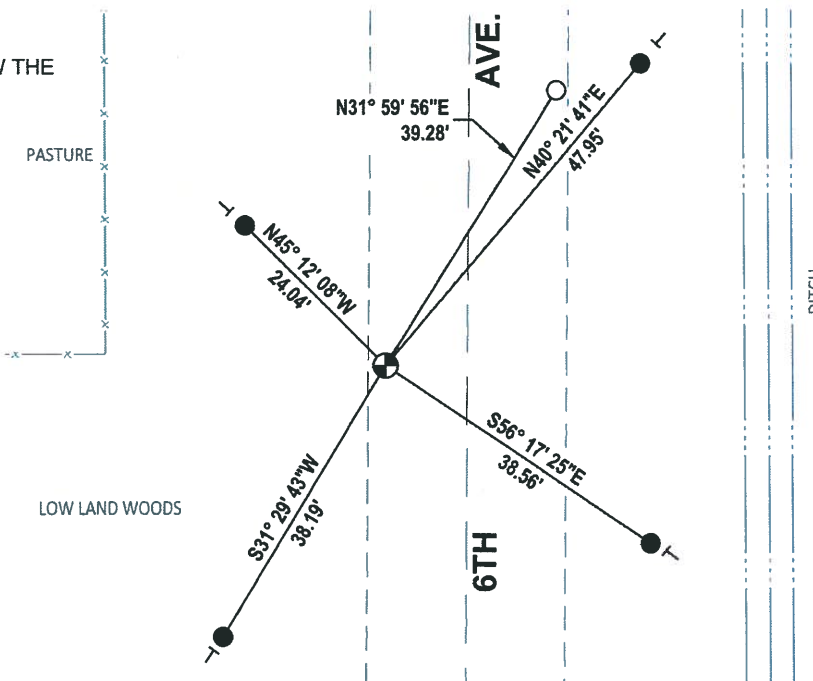


- SET 3/4" x 18" IRON REBAR, 1.50#/FT
- FOUND 3/4" IRON ROD
- ⊕ FOUND HARRISON MONUMENT
- | VINYL "T" POST

Government Land Corner Certificate

ADAMS County
 TYPE OF MONUMENT: HARRISON
 STATE PLANE COORDINATES: N _____
 E _____
 ELEVATION — M.S.L. DATUM: _____
 THETA ANGLE: _____
 FIELD BOOK: 88 PAGE 76
 DRAWN BY: L. COOMBS

CORNER NO. 75
 SECTION 19
 TOWN 20
 RANGE 7

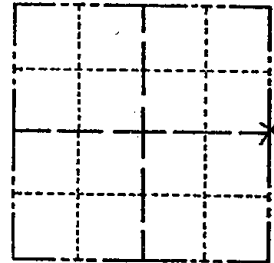

LOCATION
 (Indicated by 'X')

SEAL:



DATA SHOWN HERE ON
 CERTIFIED CORRECT:

Anthony B. Kiedrowski
 Registered Land Surveyor

DATE: 11/4/81

BASIS FOR MONUMENT LOCATION

Show info such as: History of corner, with reference to Vol. and pg., dates, surveyor; exact description of monument replaced; if location computed, by taped or EDM traverse; landowner remarks, etc. (Use reverse side if necessary)

Excavated with backhoe, found nothing, except when digging in the west shoulder I found some wire remnants of a fence that ran west from here. Corner is set on line and equidistant between section corners.

Ok 4-20-84 SS-DK

OK 4/15/94 JB-SS

OK 2-19-99-JG

ADD 1 TIE 7-7-04 SS

MON OK 2 NEW TIES 8-11-10

TIE SKETCH

Show at least four ties, also fence lines, roads, topo, size and type of witness trees and if off road - best way to arrive at corner.

