OT RANGE ADAMS COUNTY COUNTY CORNER NO: 76 ROMPORTOL ID: 42007202000


PUBLIC LAND SURVEY MONUMENT RECORD

HARRISON TYPE OF MONUMENT: ADAMS COUNTY COORDINATES, NAD 83 (2007) N. 301049.971 E. 567372.471 **ELEVATION-**DATUM 03/05/2020 FIELD WORK DATE:_

BASIS FOR MONUMENT LOCATION

1981 - PLS-878 NO RECORD OF ANY RESURVEYS. COULD FIND ABSOLUTELY NO EVIDENCE OF CORNER LOCATION. CORNER IS SET ON LINE EQUIDISTANT BETWEEN SECTION CORNERS

2020 - PLS 2675 FOUND HARRISON FLUSH WITH THE GROUND,1 TIE AND 1 WITNESS. THE MONUMENT AGREES WITH THE FOUND TIE AND WITNESS. THE MONUMENT WAS ALSO VERIFIED TO BE ON A NEAR STRAIGHT LINE AND EQUIDISTANT BETWEEN THE NE AND SE CORNERS OF SECTION 20. ACCEPTED THE HARRISON AS THE CORNER LOCATION. SET 3 NEW TIES AND MEASURED TO THE EXISTING TIE AND WITNESS.

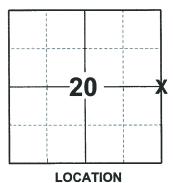

(INDICATE CORNER BY "X")




DATA SHOWN HERE ON THIS TIE SHEET IS CORRECT AND COMPLETE TO THE BEST OF MY KNOWLEDGE AND BELIEF.

PROFESSIONAL LAND SURVEYOR 2020

-TIE SKETCH



- SET 3/4" x 18" IRON REBAR, 1.50#/FT
- FOUND 3/4" IRON ROD
- FOUND HARRISON MONUMENT
- VINYL "T" POST
- WITNESS TREE
- POST W/NAIL IN WEST SIDE

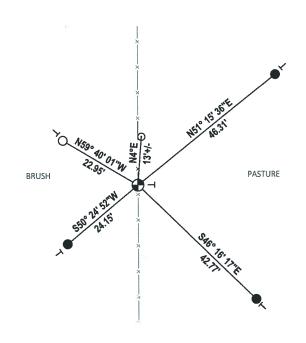

| Government Land Corn | er Certificate | | - | |
|--|--|------------------|-------------------------------------|-------------|
| ADAMS | County | | CORNER NO | |
| TYPE OF MONUMENT: HARRI | · . | | SECTION _ | 21 |
| | | | TOWN _ | ZO |
| | | | RANGE _ | 7 |
| ELEVATION — M.S.L. DATUM: THETA ANGLE: | | | -111 | 7 |
| FIELD BOOK: 88 | | | | |
| DRAWN BY: L. COOMBS | | į. | | 1 7. |
| | | | | N |
| BASIS FOR MONUMENT LOCA | TION | | | |
| Show info such as: History of corner, with and pg., dates, surveyor; exact description | h reference to Vol. ion of monument | <u> </u> | <u> </u> | |
| and pg., dates, surveyor; exact descripting replaced; if location computed, by taped landowner remarks, etc. (Use reverse side | or EDM traverse; if necessary) | | LOCATION Indicated by 'X') | |
| | | SEAL: | | Tten. |
| No record of any resurveys no evidence of corner loca | . Could find absolutely | y | ANTHONY KIEDROWS S-878 Wisconsin Ra | SINAIL |
| on line equidistant betwee | | | ANTHONY | 8. |
| Ok 4-25-84 DK-SS | | 7 | KIEDROWS S-878 | KI L |
| | | | Wisconsin Ra | pids, C 💆 |
| | | | 70. | |
| | | | SUR | VERIN |
| | | | 4688888 | 1842. |
| | | DATA SHO | WN HERE ON | |
| | | CERTIFIED | CORRECT: | - 0 |
| | | Registered La | and Surveyor | 12 chows |
| | | DATE: | 11/4/81 | |
| | | NAIL IN | WEST SIDE | OF |
| TIE SKETCH | , | MORTHERLY | | 2.2 |
| Show at least four ties, also fence lines, r and type of witness trees' and if off road arrive at corner. | oads, topo, size | كتب | G0094 | |
| 3/1"Page 35T | 93 8" ASH BT | (93 | BT | |
| OITCH BANK, 21' WES' | W Signi | . / | Nead | |
| of FENCE 22.9 TO 3 | 60 1 1 1 2 1 1 1 1 1 1 1 1 1 1 1 1 1 1 1 | A | | |
| HHX | | 8 | / | |
| | 1 1 11 1 | RER TIE FENCE PE | ন ১ | |
| | | ECOSS BRACES | | |
| m 1 | Contract of the Contract of th | | | |
| 10" (53) | FIRST | ₹ ~~Q | | |
| 16 POPALIST | 1 % | | | |
| SET 3/4 "ROD \$15' W. | <u> </u> | - | | |
| of FENCE 37.6 TO | Z61± * | (03 20 | ELM BT. | |
| of FENCE 37.6 TO HARRISON - 147' SOU | 7 | | ,, . | |
| of other ROD | | | | |
| | * | | | |
| | • | | | |

MAINTENANCE RECORD

| DATE | BY WHOM | REMARKS |
|------------|---------|---|
| 15 June 94 | JG-CR | ZNEWTIES - OK |
| 2-19-99 | Ts | OK |
| 11-10-04 | S.S | HARRISON & RR TIE FENCE POSTE ARE ALL THAT REMAINS ADD ROOS |
| 03-02-09 | 55 | POSTE ARE ALL THAT REMAINS |
| | | ADD ROOS |
| | | |
| | | · |
| | | |
| | | |
| | · · · | |
| | | |
| | | |