

21
SECTION

20
TOWN

07
RANGE

ADAMS COUNTY

COUNTY CORNER NO: 77
ROMPORTOL ID: 42007212000

PUBLIC LAND SURVEY MONUMENT RECORD

TYPE OF MONUMENT: SURVEY NAIL

ADAMS COUNTY COORDINATES, NAD 83 (2007)

N. 301074.878

E. 572678.719


ELEVATION- - - - - DATUM - - - - -

FIELD WORK DATE: 02/26/2020

BASIS FOR MONUMENT LOCATION

1981 - PLS 878 NO RECORD OF ANY RESURVEYS. EXCAVATED IN GRAVEL ROAD, FOUND NOTHING. CORNER IS SET ON LINE AND EQUIDISTANT BETWEEN SECTION CORNERS.

2020 - PLS 2675 FOUND SURVEY NAIL IN THE ROAD SURFACE AND 1 WITNESS. THE MONUMENT AGREES WITH THE WITNESS AND IS ON A NEAR STRAIGHT LINE AND EQUIDISTANT BETWEEN THE NE AND SE CORNERS OF SECTION 21. ACCEPTED THE SURVEY NAIL AS THE BEST EVIDENCE OF THE CORNER LOCATION. SET 4 NEW TIES AND MEASURED TO THE EXISTING WITNESS.

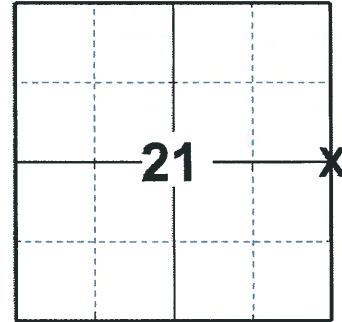

LOCATION

(INDICATE CORNER BY "X")

SEAL:




DATA SHOWN HERE ON THIS TIE SHEET IS CORRECT AND COMPLETE TO THE BEST OF MY KNOWLEDGE AND BELIEF.

PROFESSIONAL LAND SURVEYOR

DATE 3/25/2020

TIE SKETCH

NOTE: THE CORNER LANDS 9± WEST OF CTH 'W' CENTERLINE

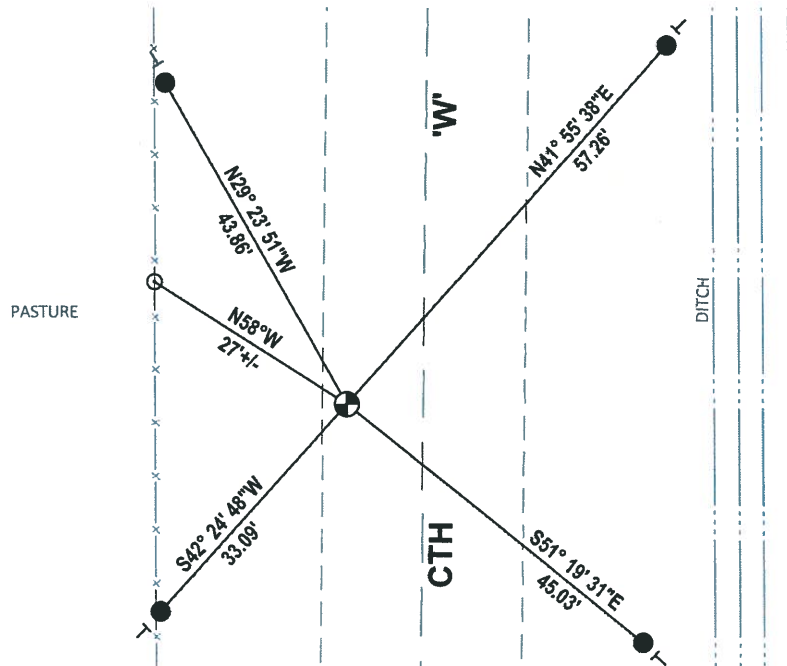


- SET 3/4" x 18" IRON REBAR, 1.50#/FT
- ⊕ FOUND SURVEY NAIL MONUMENT
- ┌ VINYL "T" POST
- ⊙ FENCE POST

Government Land Corner Certificate

ADAMS County
 TYPE OF MONUMENT: HARRISON
 STATE PLANE COORDINATES: N _____
 E _____
 ELEVATION — M.S.L. DATUM: _____
 THETA ANGLE: _____
 FIELD BOOK: 88 PAGE 83
 DRAWN BY: L. COOMBS

CORNER NO. 77
 SECTION 21
 TOWN 20
 RANGE 7

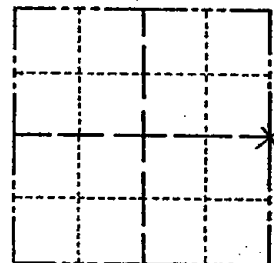

LOCATION
(Indicated by 'X')

BASIS FOR MONUMENT LOCATION

Show info such as: History of corner, with reference to Vol. and pg., dates, surveyor; exact description of monument replaced; if location computed, by taped or EDM traverse; landowner remarks, etc. (Use reverse side if necessary)

No record of any resurveys. Excavated in gravel road, found nothing. Corner is set on line and equidistant between section corners.


2 gone no new taken 4-20-84 SS-DK

OK 4/15/94 JG-SS

2-TIES REMAIN NOTHING AVAILABLE 3-5-99-JGS

" " " — Mon GONE? 10-07-09

SEAL:

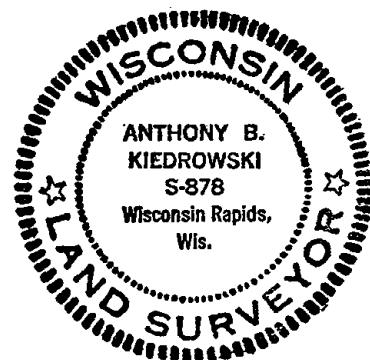

DATA SHOWN HERE ON
CERTIFIED CORRECT:

Anthony B. Kiedrowski
Registered Land Surveyor

DATE: 11/4/81

TIE SKETCH

Show at least four ties, also fence lines, roads, topo, size and type of witness trees' and if off road - best way to arrive at corner.

