OT RANGE ADAMS COUNTY COUNTY CORNER NO: 86 ROMPORTOL ID: 42007210020

PUBLIC LAND SURVEY MONUMENT RECORD

3/4"X48" REBAR TYPE OF MONUMENT: ADAMS COUNTY COORDINATES, NAD 83 (2007)

N. 298421.345

E. 569996.585

ELEVATION-DATUM


02/26/2020 FIELD WORK DATE:

BASIS FOR MONUMENT LOCATION

1976 - PLS 1103 RAN EDM/T2 TRAVERSE AROUND SECTIONS 28 AND 29, AND PORTIONS OF ADJOINING SECTIONS TO DETERMINE SEARCH AREA FOR INVESTIGATION. EXCAVATION WITH BACKHOE YIELDED NO EVIDENCE OF THE ORIGINAL CORNER OR ANY REMONUMENTATION. COULD FIND NO ORIGINAL BEARING TREES, RE-ESTABLISHED CORNER BY SINGLE PROPORTIONATE MEASURE ON LINE BETWEEN ADJACENT SECTION CORNERS.

1984 - PLS 1551 THE HARRISON MONUMENT AS SHOWN ON DALE HAGEN TIE SHEET, DATED 12/2/76 WAS FOUND. POSITION CHECKED WITH THAT SHOWN ON SECTION SUMMARY RECORD. CORNER WAS ACCEPTED AND RE-TIED AS SHOWN.

2020 - PLS 2675 FOUND NO EVIDENCE OF ANY CORNER MONUMENTATION, BUT FOUND 1 TIE AND 1 WITNESS. CALCULATED CORNER LOCATION FROM RECORDED DISTANCE FROM THE 1984 TIE SHEET. THIS CALCULATED LOCATION IS ON A NEAR STRAIGHT LINE AND EQUIDISTANT BETWEEN THE SE AND SW CORNERS OF SECTION 21. SET A 3/4"X48" REBAR FOR THE CORNER, SET 4 NEW TIES, MEASURED TO THE FOUND TIE AND WITNESS.

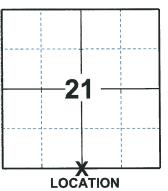

(INDICATE CORNER BY "X")




DATA SHOWN HERE ON THIS TIE SHEET IS CORRECT AND COMPLETE TO THE BEST OF MY KNOWLEDGE AND BELIEF.


PROFESSIONAL LAND SURVEYOR

3/25/2020

-TIE SKETCH

NOTE: THE CORNER LANDS 19.8'± SOUTH OF ARCHER AVE. CENTERLINE

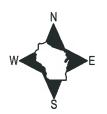

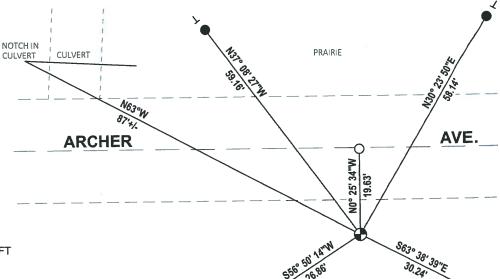

PRAIRIE

- SET 3/4" x 18" IRON REBAR, 1.50#/FT
- FOUND 3/4" IRON ROD
- SET 3/4"X48" REBAR MONUMENT

VINYL "T" POST

CORNER NO. ADAMS COUNTY SECTION Survey Monument Record TOWN TYPE OF MONUMENT: 30" HARRISON 7 RANGE STATE PLANE COORDINATES: N_ ELEVATION — M.S.L. DATUM: THETA ANGLE: File FIELD BOOK: **PAGE** BASIS FOR MONUMENT LOCATION (Use reverse side if necessary) LOCATION Show info such as: History of corner, with reference to Vol. and pg, dates, surveyor; exact description of monument replaced; if location computed, by taped or EDM traverse; landowner (Indicated by 'X') SEAL: Ran EDM/T2 traverse around sections 28 and 29, and portions of adjoining sections to determine search area for investigation. Excavation with backhoe yielded no evidence of the DALE C. original corner or any remonumentation. Could **HAGEN** find no original bearing trees. S-1103 Wisconsin Rapids Re-established corner by single proportionate Wis. measure on line between adjacent section corners. Set 11-4-76. PN-55 4-13-79 OK CERTIFIED CORRECT Registered Land Surveyor DATE: 12-2-76 TIE SKETCH (Show at least four ties) NOTE Ties in trees to nail in disc IRON PIPE WHERL ARCHER AVE. A 6 (50'Y FIE

U.S. PUBLIC LAND SURVEY MONUMENT RECORD

This form is intended and design	ned to fulfill all requirements of Wisconsin Ad	ministrative Code Chapter A F. Co. II.C.
Public Land Survey Monument R	lecord (3) (a) (b) (c) (d) (e) (f) (g) (h) (i). An add	ditional sheet may be added if necessary to
conform with said requirements. (a) Corner location: Township	20 North	· • • • • • • • • • • • • • • • • • • •
•	East/West	·
Town/City/VillageLEOLA		1 1
CountyADAMS		
		Section28
not accepted or if nothing w reestablished through lost co directions used to establish.	ument found at this corner and if it	ts) used as a basis for accepting. If basis for establishing location. If te all monuments, distances and
The harrison monumer found. Position c	ent as shown on Dale Hagen tie s hecked with that shown on section	heet, dated 12/2/76 was n summary record.
• Corner was accepted	d and re-tied as shown	•
OK 4/15/94 OK 2-19-99-	JG-55 JG 412R-0NLY 2 TIES REMAIN	11-10-04 525
(c) (d) (e) Plan view of corner with	ties to at least 4 witness monuments distances between the two corners	. If in disagreement with previously
		TTCH ITCH
•	IN W. END Z'I/G'	0 070
•	01 04	34" XZ4" REBAR SET IN RO &
	ARCHER SALES	PAN AVENUE
270-19	274.7	82
SPIKE FOUND IN GONE	Gang 4152	1
PREV. TIE	ME COR. WALSHARA ELECTRIC BOX B-19E	HARRISON MONOMENT FOUND
(i) I, DAVID C. RIESOP	S- 1551	HILLSCONS THE
as determined by me or under	the corner location on this record my direction and control and that Monument Record is correct and owledge and belief.	DAVID C. RIESOP S-1551 here CAMBRIDGE, WISCONSIN

Date

Signature