

24
SECTION

20
TOWN

07
RANGE

ADAMS COUNTY

COUNTY CORNER NO: 92

ROMPORTOL ID: 42007240020

PUBLIC LAND SURVEY MONUMENT RECORD

TYPE OF MONUMENT: HARRISON
ADAMS COUNTY COORDINATES, NAD 83 (2007)

N. 298556.110

E. 585971.203


ELEVATION- DATUM

FIELD WORK DATE: 02/18/2020

BASIS FOR MONUMENT LOCATION

2013 - PLS 2608 PREVIOUS MONUMENT LOST DUE TO CULVERT REPLACEMENT. SET NEW HARRISON CAST IRON MONUMENT AT LOCATION USING PRIOR SURVEY IN SECTION 24 AND SURVEYS BY OTHERS IN SECTION 25.


2020 - PLS 2675 FOUND HARRISON 12"± BELOW THE ROAD SURFACE AND 4 TIES. THE MONUMENT AGREES WITH ALL 4 TIES. ACCEPTED THE HARRISON AS THE CORNER LOCATION AND MEASURED TO THE EXISTING TIES.

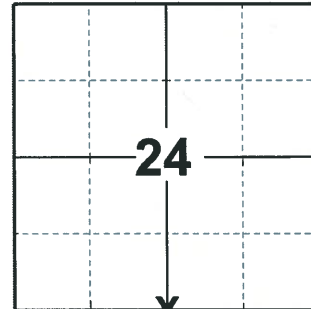

LOCATION

(INDICATE CORNER BY "X")

SEAL:

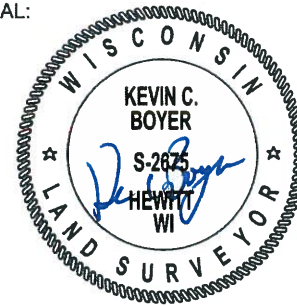



DATA SHOWN HERE ON THIS TIE SHEET IS CORRECT AND COMPLETE TO THE BEST OF MY KNOWLEDGE AND BELIEF.

PROFESSIONAL LAND SURVEYOR

DATE 3/25/2020

- TIE SKETCH

NOTE: THE CORNER LANDS 6.7'± EAST OF 1ST DR. CENTERLINE

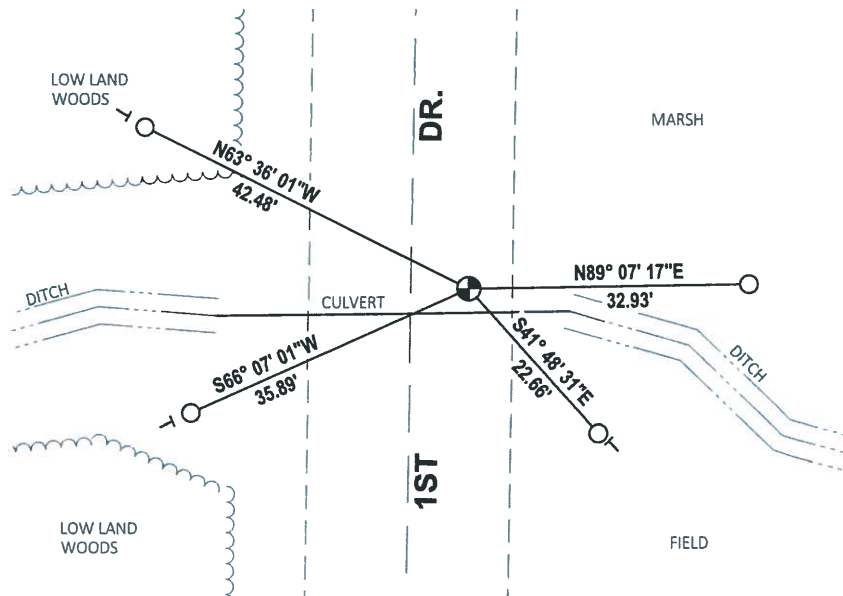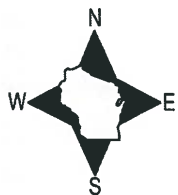

- FOUND 3/4" IRON ROD
- ⊕ FOUND HARRISON MONUMENT
- VINYL "T" POST

Government Land Corner Certificate

Adams County

TYPE OF MONUMENT: HARRISON CAST IRON MONUMENT

STATE PLANE COORDINATES: N _____
E _____

ELEVATION - M.S.L. DATUM: _____

THETA ANGLE: _____

FIELD BOOK: _____ PAGE _____


DRAWN BY: JIM BRASEL

REFERENCE FOR SURVEY RECORDED IN: _____

CORNER VOL. _____, PAGE _____

CORNER # 92

SECTION 25, T 20 N, R, 7E

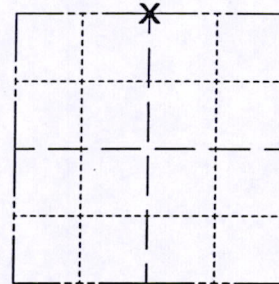

LOCATION

(Shown by monument symbol)

BASIS FOR MONUMENT LOCATION

Show info such as: History of corner, with reference to Vol. and pg., dates, surveyor; exact description of monument replaced; if location computed, by taped or EDM traverse; landowner remarks, etc. (Use reverse side if necessary)

PREVIOUS MONUMENT LOST DUE TO CULVERT REPLACEMENT.
SET NEW HARRISON CAST IRON MONUMENT AT LOCATION
USING PRIOR SURVEY IN SECTION 24 AND SURVEYS BY
OTHERS IN SECTION 25.

SEAL:




DATA SHOWN HEREON
CERTIFIED CORRECT:

Donald J. Schmolff
Registered Land Surveyor

DATE: NOVEMBER 25, 2013

TIE SKETCH

Show at least four ties, also fence lines, roads, topo, size and type of witness trees' and if off road - best way to arrive at corner.

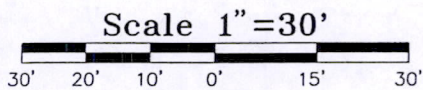

LEGEND:

- ⊕ HARRISON CAST IRON MONUMENT SET
- 3/4"x24" REBAR SET-1.502 LB/FT.
- ⊗ POWER POLE
- e- AERIAL ELECTRIC LINE

