OT RANGE ADAMS COUNTY CORNER NO: 95 ROMPORTOL ID: 42007302000

PUBLIC LAND SURVEY MONUMENT RECORD

HARRISON TYPE OF MONUMENT: ADAMS COUNTY COORDINATES, NAD 83 (2007) N. 295736.732

ELEVATION-___- - ---DATUM


03/05/2020 FIELD WORK DATE:_

E. 562050.138


BASIS FOR MONUMENT LOCATION

1976 - PLS 1103 RAN EDM/T2 TRAVERSE AROUND SECTIONS 28 AND 29, AND PORTIONS OF ADJOINING SECTIONS TO DETERMINE SEARCH AREAS. COULD FIND NO EVIDENCE OF THE ORIGINAL CORNER OR AND REMONUMENTATION. COULD FIND NO ORIGINAL BEARING TREES. RE-ESTABLISHED CORNER BY SINGLE PROPORTIONATE MEASURE ON LINE BETWEEN ADJACENT SECTION CORNERS. SET HARRISON MONUMENT ON 11-4-76.

2020 - PLS 2675 FOUND HARRISON 4"± ABOVE THE GROUND AND 1 WITNESS. THE MONUMENT AGREES WITH THE WITNESS. ACCEPTED THE HARRISON AS THE CORNER LOCATION. SET 4 NEW TIES AND MEASURED TO THE EXISTING WITNESS.

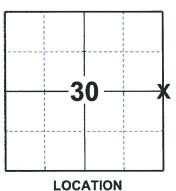

(INDICATE CORNER BY "X")

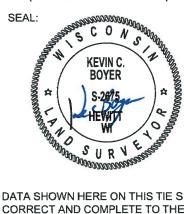

DATA SHOWN HERE ON THIS TIE SHEET IS CORRECT AND COMPLETE TO THE BEST OF MY KNOWLEDGE AND BELIEF.


PROFESSIONAL LAND SURVEYOR

2/25/2020

-TIE SKETCH



- SET 3/4" x 18" IRON REBAR, 1.50#/FT
- FOUND HARRISON MONUMENT
- STEEL FENCE POST
- VINYL "T" POST WITNESS TREE

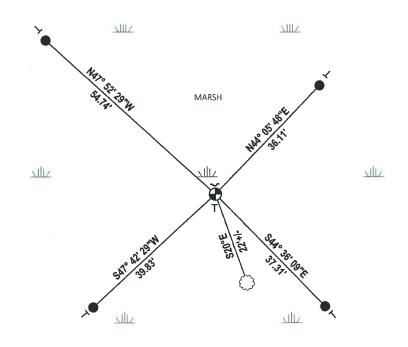

CORNER NO. ADAMS COUNTY 29 SECTION Survey Monument Record 20 TYPE OF MONUMENT: Standard Harrison TOWN 7 RANGE STATE PLANE COORDINATES: N ELEVATION — M.S.L. DATUM: THETA ANGLE: -37 68 FIELD BOOK: ... PAGE . BASIS FOR MONUMENT LOCATION (Use reverse side if necessary) Show info such as: History of corner, with reference to Vol. and pg, dates, surveyor; exact description of monument replaced; if location computed, by taped or EDM traverse; landowner LOCATION (Indicated by 'X') SEAL: Ran EDM/T2 trafferse around Sections 28 and 29, and portions of adjoining sections to determine search areas. Could find no evidence of the original corner or DALE C. and remonumentation. Could find no original **HAGEN** bearing trees. S-1103 Wisconsin Rapids Re-established corner by single proportionate measure on line between adjacent section corners. Set Harrison monument on 11-4-76. 01 11-3-79 85-55 0k 4-20-84 SS-DK Registered Land Surveyor 12-2-76 2-GONE, 3-NEW TIES 6-16-94 B5-J6 2-19-99-TIE SKETCH Z NEW TIES (Show at least four ties) GONE 941 NOTE Ties in trees to nail in disc. +40'W. of OLD ROAD BED IISW. of ap ROAD BED New

