OT ADAMS COUNTY COUNTY

PUBLIC LAND SURVEY MONUMENT RECORD

SURVEY NAIL TYPE OF MONUMENT: ADAMS COUNTY COORDINATES, NAD 83 (2007)

N. 293248.241

E. 583327.982


ELEVATION-DATUM

FIELD WORK DATE:_ 02/27/2020


BASIS FOR MONUMENT LOCATION

1975 - PLS 1103 RAN EDM/TRANSIT TRAVERSE AROUND SECTION 35 AND 36 TO DETERMINE SEARCH AREAS. COULD FIND NO EVIDENCE OF THE ORIGINAL CORNER OR ANY REMONUMENTATION, OR ACCESSORY MONUMENTS AFTER EXCAVATION WITH BACKHOE. SET CORNER BY PROPORTIONATE MEASURE BETWEEN SECTION CORNERS TO EAST AND WEST. AND BY DOUBLING OVER DISTANCE BETWEEN SOUTHWEST AND WEST QUARTER CORNER.

2020 - PLS 2675 FOUND NO MONUMENT, TIES, OR WITNESS FOR THIS CORNER. CALCULATED THE CORNER LOCATION ON A STRAIGHT LINE FROM THE SW AND \$1/4 EAST AND A DISTANCE OF 2661.12' PER SECTION 26 SECTION SUMMARY. THIS LOCATION ALSO AGREES WITH THE SOUTH LINE OF SW1/4 SECTION DISTANCE FROM THE SECTION 25 SUMMARY OF 2634.18'. ACCEPTED THIS AS THE CORNER LOCATION. SET A SURVEY NAIL AT THIS CALCULATED LOCATION AND SET 4 NEW TIES.

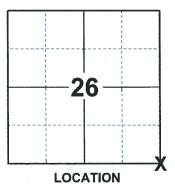

(INDICATE CORNER BY "X")

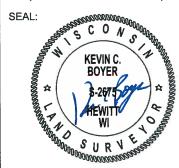


DATA SHOWN HERE ON THIS TIE SHEET IS CORRECT AND COMPLETE TO THE BEST OF MY KNOWLEDGE AND BELIEF.

PROFESSIONAL LAND SURVEYOR 3/25/2020

-TIE SKETCH

NOTE: THE CORNER LANDS 14.8'± WEST OF CTH 'G' CENTERLINE AND 19.3'± SOUTH OF CTH 'O'/ASPEN AVE. CENTERLINE



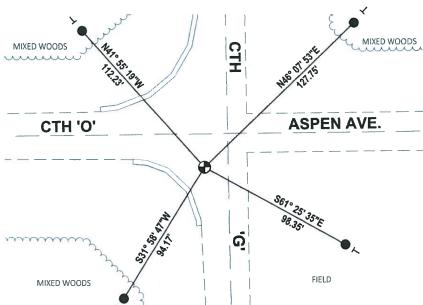

- SET 3/4" x 18" IRON REBAR, 1.50#/FT
- SET SURVEY NAIL MONUMENT
- VINYL "T" POST

CORNER NO. 65 ADAMS COUNTY SECTION Survey Monument Record 20 TOWN 3/4"x 24" IRON ROD TYPE OF MONUMENT: Harrison Monument 7 RANGE STATE PLANE COORDINATES: N. ELEVATION - M.S.L. DATUM: _ THETA ANGLE: _ FIELD BOOK: ___ _ PAGE . BASIS FOR MONUMENT LOCATION (Use reverse side if necessary) LOCATION Show info such as: History of corner, with reference to Vol. and pg, dates, surveyor; exact description of monument replaced; if location computed, by taped or EDM traverse; landowner (Indicated by 'X') SEAL: Ran EDM/transit traverse around Section 35 and 36 to determine search areas. Could find no evidence of the original corner or anyly remonumentation, or accessory monuments DALE C. after excavation with backhoe. HAGEN S-1103 Wisconsin Rapids Set corner by proportionate measure between section corners to East and West, and by doubling over distance between Southwest and West Quarter conner. 3-22-79 PN-JSK CERTIFIED CORRECT HARRISON GONE, RESET 3/4'X 24" /RON ROD FROM TIES 2-60NE, 2-NEW TIES 6/16/94 BS-JG Registered Land Surveyor DATE: May 5. OK 2-12-99-JG FO 3/4" POO -AOD ITIE TIE SKETCH (Show at least four ties) THEMUNENT NONEXISTANT NOTE: Ties in trees to nail in disc. Bearing trees marked BT are scribed with BT facing corner. NEW Box

REVISED 1974

Character of the State of

•