# OT ADAMS COUNTY

COUNTY CORNER NO: 129

ROMPORTOL ID: 42007340000


## PUBLIC LAND SURVEY MONUMENT RECORD

**HARRISON** TYPE OF MONUMENT: ADAMS COUNTY COORDINATES, NAD 83 (2007) N. **287931.141** E. 578020.136 ELEVATION- - - -DATUM - - -FIELD WORK DATE: 02/02/2018


#### BASIS FOR MONUMENT LOCATION

1972 - PLS 878 STATES LOCAL LANDOWNER ARCHIE GEAR RECALLED SEEING A STONE HERE YEARS AGO. EXCAVATED WITH A BACKHOE AND FOUND A 6"X6"X16" STONE. MR. GEAR WAS PRESENT DURING EXCAVATION. (THIS CORNER PART OF SLIDE COLLECTION) SET A HARRISON MONUMENT AND TIED OUT.

2018 - PLS 2994 FOUND HARRISON 4" BELOW THE ROAD SURFACE AND 2 WITNESSES. THE MONUMENT AGREES WITH THE WITNESSES. ACCEPTED THE HARRISON AS THE CORNER. SET 4 NEW TIES AND MEASURED TO THE WITNESSES.

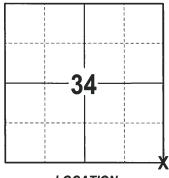

LOCATION (INDICATE CORNER BY "X")

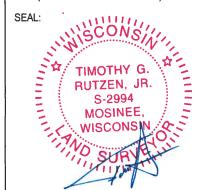


DATA SHOWN HERE ON THIS TIE SHEET IS CORRECT AND COMPLETE TO THE BEST OF MY KNOWLEDGE AND BELIEF.

PROFESSIONAL LAND SURVEYOR

### - TIE SKETCH

NOTE: THE CORNER FALLS 3'± NORTH OF THE CENTERLINE OF BADGER AVE AND 2'± WEST OF THE CENTERLINE OF 3RD AVE.



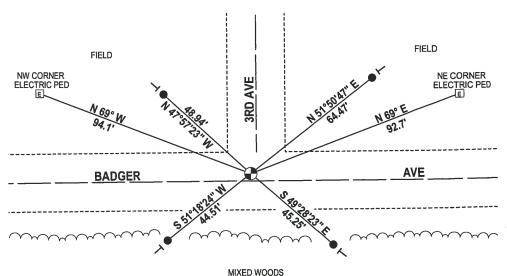

• 3/4" x 18" IRON REBAR SET, 1.50#/FT HARRISON FOUND

→ VINYL "T" POST

#### ADAMS COUNTY CORNER NO. \_ 34 **SECTION** Survey Monument Record **TOWN** TYPE OF MONUMENT: 30" HARRISON 7 RANGE STATE PLANE COORDINATES: N E ELEVATION - M.S.L. DATUM: -THETA ANGLE: \_ 107 FIELD BOOK: \_\_\_\_ \_\_ PAGE \_ BASIS FOR MONUMENT LOCATION (Use reverse side if necessary) ANTHONY B. KIEDROWSKI S-878 Wisconsin Re-Show info such as: History of corner, with reference to Vol. and pg, dates, surveyor; exact description of monument replaced; if location computed, by taped or EDM traverse; landowner remarks, etc. The state of the s October 4, 1972 Anthony B. Kiedrowski R.L.S. Local landowner Archie Gear recalled seeing a stone here years ago. We excavated with a backhoe and found a 6"x6"x16" stone. Mr. Gear was present during excavation. (This corner part of slide collection. CERTIFIED CORRECT: 29 X 11.3.19 3:5-55 Registered Lond Surveyor DATE: -Z 0k 4-27-84 DK-SS JG-55 1-NEW 3-16-94 2-12-99- JG OK TIE SKETCH TIES 2 NEW 2.6-09 55 (Show at least four ties) OX NOTES: STREET SIGN 1) All nails in trees are Railroad Spikes. 0 2) Pine trees tied are White Pine. COR ELEC. BOX 'ABC" NW COR ELEC BOX "SP 36" @ C.T.H. "O" SANGE O

1/4 IRON PIPE

2 - 2 - 77

6143

GPR.