OT ADAMS COUNTY

COUNTY CORNER NO: 131

ROMPORTOL ID: 42007350000

PUBLIC LAND SURVEY MONUMENT RECORD

HARRISON (BROKEN-TOP) TYPE OF MONUMENT: ADAMS COUNTY COORDINATES, NAD 83 (2007) N. **287971.765** E. 583300.028 **ELEVATION-**DATUM

FIELD WORK DATE: 02/02/2018


BASIS FOR MONUMENT LOCATION

1975 - PLS 878 EXCAVATED WITH A BACKHOE AND FOUND A 6"X7" TOP AND A 6"X12" BOTTOM OF A GRANITE STONE. LOWERED THE STONE AND SET A HARRISON MONUMENT ON TOP. EDM TRAVERSE OF SECTION 36 INDICATES THE STONE WAS LOCATED AT THE CORRECT LOCATION. NO OTHER EVIDENCE OF THE CORNER WAS FOUND. NO RECORDS OF ANY RESURVEYS, TIED OUT CORNER.

2018 - PLS 2994 FOUND HARRISON WITH BROKEN-TOP 40" BELOW THE ROAD SURFACE AND DID NOT RECOVER ANY WITNESSES OR TIES, ACCEPTED THE HARRISON WITH BROKEN-TOP AS THE CORNER. SET AND MEASURED TO 4 NEW



LOCATION (INDICATE CORNER BY "X")

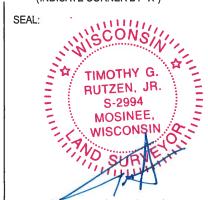

DATA SHOWN HERE ON THIS TIE SHEET IS CORRECT AND COMPLETE TO THE BEST OF MY KNOWLEDGE AND BELIEF.


PROFESSIONAL LAND SURVEYOR

3-1-18

- TIE SKETCH NOTE: THE CORNER FALLS 1'± WEST OF THE CENTERLINE OF CTH G.





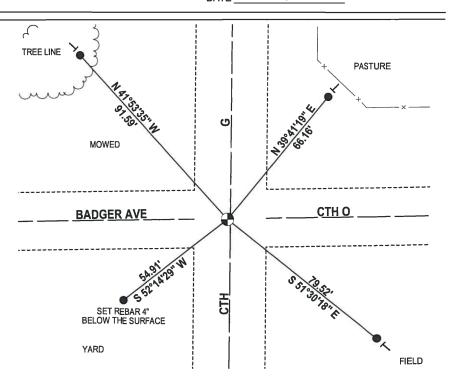

ADAMS COUNTY

Survey Monument Record

Harrison standard TYPE OF MONUMENT: __

STATE PLANE COORDINATES: N.

ELEVATION - M.S.L. DATUM: _

THETA ANGLE: _

FIELD BOOK: ___ PAGE .

LOCATION

(Indicated by 'X')

CORNER NO.

SECTION

TOWN

RANGE

36

20

SEAL:

BASIS FOR MONUMENT LOCATION

(Use reverse side if necessary)

Show info such as: History of corner, with reference to Vol. and pg, dates, surveyor; exact description of monument replaced; if location computed, by taped or EDM traverse; landowner remarks, etc.

Excavated with backhoe. Found 6"x7" tpp and 6"x12" bottom by 16" deep granite stone. Lowered stone and set Harrison on top. EDM traverse of section 36 indicates stone located at correct point. No other evidence of corner. No records of resurveys.

S-878 Wisconsin Rapids, Wis.

3-19-79 RN-DJW ZNEW TIES ZMARCH94 CR-55

2 NEW TIES 10-07-09 2-12-99

CERTIFIED CORRECT Registered Land Surveyor DATE: 4/29/75

TIE SKETCH (Show at least four ties) 16" Red OAK Ties to nail and disc. GONF 94 8" JACK PINE 10 RED NOT BLAZED 15'SPRUCE square metal tab)