SECTION

TOWN

# OB ADAMS COUNTY

COUNTY CORNER NO: 126

ROMPORTOL ID: 41706330020

## PUBLIC LAND SURVEY MONUMENT RECORD

HARRISON (BROKEN TOP) TYPE OF MONUMENT: ADAMS COUNTY COORDINATES, NAD 83 (2007) N. **192364.766** E. 539147.510

DATUM — — **ELEVATION-**


11/27/2017 FIELD WORK DATE:

## BASIS FOR MONUMENT LOCATION

1978 - PLS 1267 FOUND NO EVIDENCE OF BEARING TREES OR THE CORNER. TRAVERSED THE SECTION BY E.D.M. AND T-2 AND COMPUTED THE LOCATION BY SINGLE/PROPORTION FROM THE S1/4 OF SECTION 32 TO THE SE CORNER OF SECTION 33. SET A HARRISON MONUMENT AT THE CALCULATED LOCATION AND TIED OUT.

1981 - PLS 1478 SET A NEW HARRISON MONUMENT EQUIDISTANT AND ONLINE BETWEEN ADJOINING SECTION CORNERS. EXCAVATION AT THIS LOCATION YIELDED NO EVIDENCE OF ANY PREVIOUS MONUMENTATION. THIS LOCATION BEST FITS ALL THE COLLATERAL EVIDENCE IN THE ADJOINING SECTIONS. NOTE, THE NEW CORNER LOCATION IS APPROXIMATELY 28.52' SOUTHWEST OF PRIOR 1978 LOCATION ESTABLISHED BY PLS 1267.

2017 - PLS 2994 FOUND HARRISON MONUMENT SET BY PLS 1479, 3" BELOW THE ROAD SURFACE AND 1 TIE. THE MONUMENT AGREES WITH THE EXISTING TIE. ACCEPTED THE HARRISON MONUMENT AS THE CURRENTLY HELD CORNER LOCATION. SET 4 NEW TIES AND MEASURED TO THE TIES AND WITNESS.

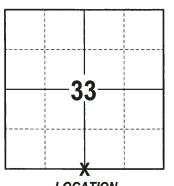

LOCATION (INDICATE CORNER BY "X")

SEAL: Wiscow TIMOTHY G. RUTZEN, JR. S-2994 MOSINEE WISCONSI

DATA SHOWN HERE ON THIS TIE SHEET IS CORRECT AND COMPLETE TO THE BEST OF MY KNOWLEDGE AND BELIEF.

PROFESSIONAL LAND SURVEYOR

12-21-17 DATE

### - TIE SKETCH

NOTE: THE CORNER FALLS 3.5'± SOUTH OF THE CENTERLINE OF CTH E.



FIELD OPEN HARDWOODS <u>CTH</u>

 3/4" x 18" IRON REBAR SET, 1.50#/FT O 3/4" IRON ROD FOUND (PRÉVIOUS CORNER LOCATION) HARRISON FOUND

→ VINYL "T" POST

FIFI D

## Government Land Corner Certificate


ADAMS	County
TYPE OF MONUMENT: HARRI	
STATE PLANE COORDINATES:	N
	E
ELEVATION — M.S.L. DATUM:	
THETA ANGLE:	
FIELD BOOK:	
DRAWN BY: S.S.	

## BASIS FOR MONUMENT LOCATION

Show info such as: History of corner, with reference to Vol. and pg., dates, surveyor; exact description of monument replaced; if location computed, by taped or EDM traverse; landowner remarks, etc. (Use reverse side if necessary)

> Set monument aquidistant and on line between adjoining section corners. Excavation at this location yeilded no evidence of any previous monumentation. This location fits collateral evidence within the adjacent sections well.

CORNER NO. SECTION TOWN RANGE

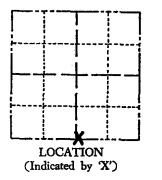

SEAL:



DATA SHOWN HERE ON CERTIFIED CORRECT:


Registered Dand Surveyor

DATE:

- 1

#### TIE SKETCH


Show at least four ties, also fence lines, roads, topo, size and type of witness trees' and if off road - best way to arrive at corner.

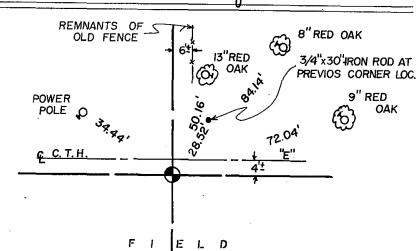

#### MAINTENANCE RECORD

Date	Init.	Remarks	
9-25-85	S5 MB	AllOK	
1-11-90	55	oK	
8-3-94	JG-35	OK	
2-14-00	JG	DK.	
1-28-05	JG	ak.	

NOTE: ALL TIES ARE P.K. NAIL AND SHINER. TREES BLAZED

 

	ODAMS C	ounts	CORNER NO	
	MENT:	<del>_</del>	SECTION .	33
	OORDINATES: N		TOWN .	17 N
	E		RANGE .	6 E
ELEVATION —	M.S.L. DATUM:	<u> </u>	<del> </del>	
THETA ANGLE:		<del></del>		
	PAC			4
DRAWN BY:		<u> </u>	77	_ NI
				או
BASIS FOR MO	NUMENT LOCATION			·
Show info such as:	History of corner, with referen	ce to Vol.	<u> </u>	
replaced; if location	rveyor; exact description of computed, by taped or EDM	traverse:	LOCATION	
andowner remarks,	etc. (Use reverse side if nece	sary)	(Indicated by 'X') SEAL:	
		ince original in 1850,		•
	dence of BT's. Tra		KENNETH H. SCHUETTE S-1267 BARABOO, WIS.	
	y EDM and T-2 to se	t corners by single ction 33 and S¼ Sectio	AND AND THE PARTY OF THE PARTY	12
		i and remains of stake	KENNETH H.	1 8
	U.S. Not <b>es</b> , 1850.		SCHUETTE SCHUETTE	1.2
computed and	set on line.	<b>.</b>	9-1267 BARABOO	147
			Wis.	
	(		1 2 1 N	A Se
5 60012	. The constant		SURV	E Been
C a .1	tie sheet!		DATA SHOWN HERE ON	Ba.
see hem	the spece.			·
			CERTIFIED CORRECT:	
			Registered Land Surveyor	≥
			DATE: 21 Dec 19	72
			DATE: AT DIC 17	10
TIE SKETCH			REMNANTS OF SOLD FENCE	P.K./SHINER & 8"DIA. RED O
Show at least four	ties, also fence lines, roads, to		<b>P</b>	O.DIA. RED U
ana type of witnes: arrive at corner.	s trees' and if off road - best	way to 9"DIA. RED OAK	7. × P.K./SHINER IN 13 DIA. RED OAK/8/	773
		Core	f /	
		(D)		P.K./SHINER II
	/\	i CF.	·   18/ 45.86	9"DIA. RED OA
	/1	POWER	\ ! &/ °9/	B7
	V	POLE	52.82	<b>(5)</b>
	Į,	×	_ × _ × _ × _	×
•	}	28	2.4	
		<u>√€</u> C.T.H."E"		·
MAIN	TENANCE RECORD		Ova-	
Date Init.	Remarks		OVERHEAD POWER	
3/10/80 RN-S	OK		WER	
		·	<b>~</b>	INE
			<i>:</i>	
		<del>-</del>		
		<del></del>		

NOTE = ALL TREES BLAZED

. .