36 SECTION

OB ADAMS COUNTY

COUNTY CORNER NO: 133

ROMPORTOL ID: 41506360000

PUBLIC LAND SURVEY MONUMENT RECORD


HARRISON TYPE OF MONUMENT: ADAMS COUNTY COORDINATES, NAD 83 (2007) N. <u>132902.56</u>5 E. 557671.892 DATUM **ELEVATION-**09/13/2017 FIELD WORK DATE:

BASIS FOR MONUMENT LOCATION

1975 - PLS 922 FOUND PK NAIL, SET BY SAM MULLEN. EXCAVATED AND FOUND 8"X6"X5" STONE. WE RETRACED MULLEN'S SURVEY TO CONFIRM THESE POINTS ARE IN IDENTICAL HORIZONTAL POSITION. SET A 30" HARRISON MONUMENT AT THE CORNER LOCATION AND TIED OUT.

1999 - PLS 1397 EXISTING MONUMENT WAS FOUND AT THE CORNER LOCATION. MONUMENT WAS REMOVED AND RAISED DUE TO RECONSTRUCTION OF C.T.H. B. RE-TIED CORNER.

2017 - PLS 2994 FOUND A HARRISON MONUMENT 6" BELOW THE ROAD SURFACE AND 5 WITNESSES. THE MONUMENT AGREES WITH THE EXISTING WITNESSES. ACCEPTED THE HARRISON MONUMENT AS THE CORNER LOCATION. SET 4 NEW TIES AND MEASURED TO THE TIES AND WITNESSES.

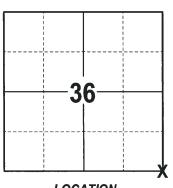

LOCATION (INDICATE CORNER BY "X")

SEAL: TIMOTHY G. RUTZEN, JR. S-2994 MOSINEE. WISCONSII

DATA SHOWN HERE ON THIS TIE SHEET IS CORRECT AND COMPLETE TO THE BEST OF MY KNOWLEDGE AND BELIEF.

PROFESSIONAL LAND SURVEYOR

DATE


- TIE SKETCH

NOTE: THE CORNER FALLS 1'± SOUTH OF THE CENTERLINE OF GALE AVE.



3/4" x 18" IRON REBAR SET, 1.50#/FT HARRISON FOUND WITNESS POWER POLE I TELEPHONE BOX (TOP CENTER)


VINYL "T" POST WITNESS TREE FOUND

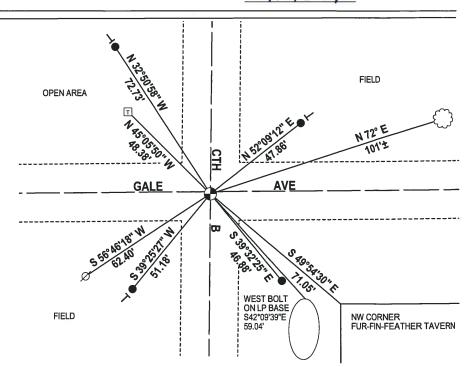

Survey Monument Record	SECTION	1
Sur vey Monument Accord		······
	TOWN _	14N
	RANGE _	6E
E	Ţ- 	*
ELEVATION — M.S.L. DATUM:		
THETA ANGLE: PAGE	† <u></u>	
FIELD BOOK:PAGE	 	N
	ļ <u>.</u>	
BASIS FOR MONUMENT LOCATION		
(Use reverse side if necessary)	LOCATION	J
	dicated by 'X')	
	CONO	% .
Existing Monument was found in place.	SCONSIA	THE STATE OF THE S
Monument was removed and raised due to	DENNIST	\ . !!
reconstruction of C.T.H. "B". All tie measurements are horizontal measurements	RUSSELL	THE THE PARTY OF T
unless noted otherwise.	8-1397 MADISON,	
reconstruction of C.T.H. "B". All tie measurements are horizontal measurements unless noted otherwise. OI- ALL OR MH. 39 ALL OR 1-18-06-JG	W /	
ALL OK, 1-18-06-JG	SURVE	I BEEFER
	SURVE	ja.
CERTIFIED C	ORRECT!	1
Denne	A Buss	ell
Registered Land	Surveyor 199	79
DATE:	7	/
TIE SKETCH		
TIE SKETCH (Show at least four ties) ALL MEASUREMENTS A	RE HORIZONTAL.	



ADAMS COUNTY		145
	CORNER NO.	172
Survey Monument Record	SECTION	147
TYPE OF MONUMENT: 30" HARRISON MARKER STATE PLANE COORDINATES: N	TOWN	6E
E	RANGE _	6E
ELEVATION — M.S.L. DATUM:		*
THETA ANGLE:		
FIELD BOOK: PAGE		
		T IN
BASIS FOR MONUMENT LOCATION		
(Use reverse side if necessary)		
Show info such as: History of corner, with reference to Vol. and pg, dates, surveyor; exact description of monument replaced; if location computed, by taped or EDM traverse; landowner remarks, etc.	LOCATION (Indicated by X') SEAL: FREDERIC W. ZIETLOW S-922 Baraboo WIS. SIIRNE	
	Milling.	
FOUND PK NAIL, SET BY SAM MULLEN,	MINISCONSIN	11/2
EXCAVATED AND FOUND 8"X6"X5" STONE	FREDERIC	
WE RETRACED MULLEN'S SURVEY TO FIND THESE	ZIFTLOW	
POINTS WHICH ARE IN IDENTICAL HORIZONTAL	S-922	;*∃
CAR, 10 : 10 - 14.76 75-25	Baraboo	/ E
1901) 1 + icc ok 10/10/81 TH-LC	WIS.	2/17
The transfer of the same	SURVE	,,,
1145 5-14-71 -1116		
1145 5-14-7 7/1C	·	
COR OK 12/6/95 JC-55	•	

 

ADAMS COUNTY	CORNER NO.	145
Survey Monument Record	SECTION	. 1
TYPE OF MONUMENT: 30" HARRISON MARKER	TOWN	14 N
STATE PLANE COORDINATES: N	RANGE	6E
E		_ >
ELEVATION — M.S.L. DATUM: THETA ANGLE:		
FIELD BOOK: PAGE		
BASIS FOR MONUMENT LOCATION		
(Use reverse side if necessary)	<u> </u>	
Show info such as: History of corner, with reference to Vol. and pg, dates, surveyor; exact description of monument replaced; if location computed, by taped or EDM traverse; landowner remarks, etc.	LOCATION (Indicated by 'X') SEAL: FREDERIC W. ZIETLOW S-922 Baraboo WIS. SURVE	
5 224 NA 11 724	WINSCONS!	11/2
FOUND PK NAIL, SET BY SAM MULLEN,	FREDERIC	1/1/2
EXCAVATED AND FOUND 8"X6"X5" STONE	₹ . W.	
WE RETRACED MULLENS SURVEY TO FIND THESE	ZIETLOW	1. =
POINTS WHICH ARE IN IDENTICAL HORIZONTAL POSITION	S-922 Baraboo	
CORNER O.K. 10-14-76 JS-SS	WIS.	03
MON 1 ties O.K. 10/10/81 TH-LC	WIS. NO SURVE	Will.
7/1.86 68-55	WWW.	•
	•,	
ALL OK 11-1-90 JG-SS	CERTIFIED CORRECT:	
SEE TIESHEET DID 5/14/91 ME	Frederic W. Ziet	1
Col. OK 12/6/95 56-55	Registered Land Surveyor	
7 1/ 3 2 3 3	DATE: APRIL 30,	1975
TIE SKETCH		
(Show at least four ties)	•	•
		a
GONE	Zo" BURR	
CUT OFF UTILITY POLE 375P SIGN /	OAK	N
0	<u> </u>	
101.45		
E GALE AVE.		
48.35		
UTILITY		
1 1 2 8		
LIGHT POLE		. "
£ 5 /- 8	FUR-FIN- FEATHER TAVERN	
JUNE TOURRY	@ GROUND	

		•
		,
		,