ADAMS COUNTY U.S. PUBLIC LAND SURVEY MONUMENT LOCATION RECORD

[X] FOUND
[ ] SET
[ ] RE-SET
[X] RE-TIED

CORNER # 23
SECTION 8
TOWNSHIP 16 NORTH
RANGE 6 EAST

SECTION 8

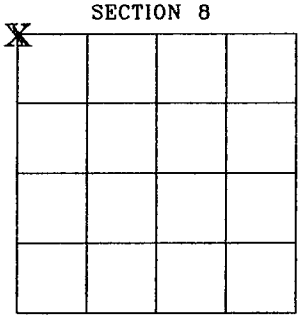

[X] LANDMARK [ ] BENCHMARK

CORNER IDENTITY BERNTSEN SURVEY NAIL SET

COUNTY COORDINATES: N. 191,171.48
E. 531,216.56

ELEVATION

WEATHER

DATE OF SURVEY June 24, 2013

SURVEY PARTY Dennis J. Christie, RLS

BASIS FOR MONUMENT LOCATION:

(DESCRIBE METHOD OF SURVEY AND CORNER AUTHENTICATION)

HARRISON MONUMENT FOUND

TOP BROKEN OFF

NOT DISTURBED BY PROJECT.

WISCONSIN
DENNIS J. CHRISTIE
S-1452
Green Bay, Wis.
LAND SURVEYOR

8/28/13

TIE SKETCH:

SHOW MINIMUM OF FOUR (4) HORIZONTAL TIE DISTANCES TO FIXED WITNESS MONUMENTS. DESCRIBE ALL MONUMENTS FOUND OR SET.

DRAWING IS NOT TO SCALE.

LEGEND

HARRISON MONUMENT FOUND TOP BROKEN OFF
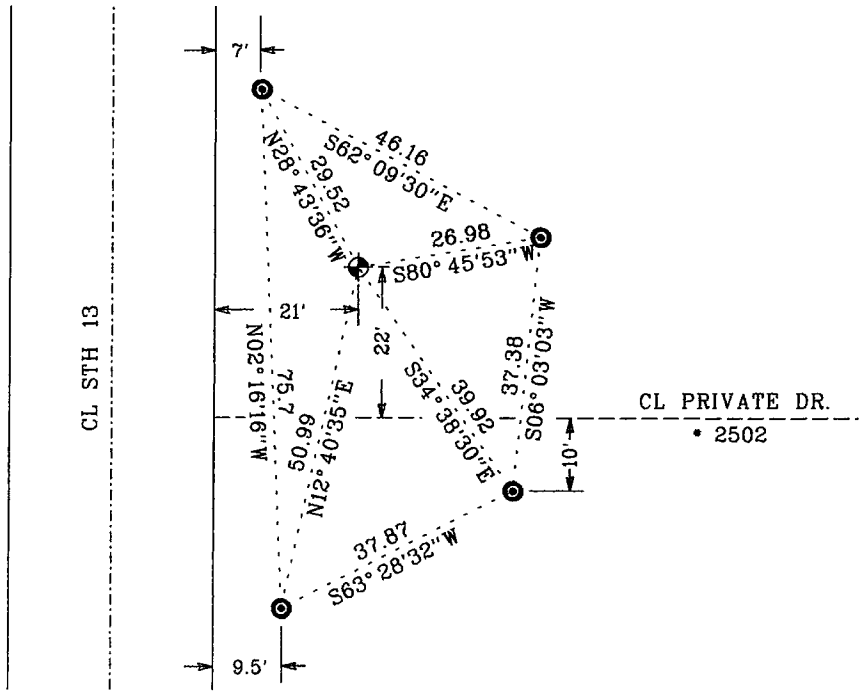
BERNTSEN MONUMENT A2BR30 SET