Government Land Corner Certificate

ADAMS County HARRISON

TYPE OF MONUMENT: ~~3/4" x 24" Iron Rod - replace in~~ spring

STATE PLANE COORDINATES: N

E

ELEVATION — M.S.L. DATUM:

THETA ANGLE:

FIELD BOOK: 3 PAGE 18

DRAWN BY: S. Sorensen

CORNER NO. 24

SECTION 8

TOWN 16

RANGE 6

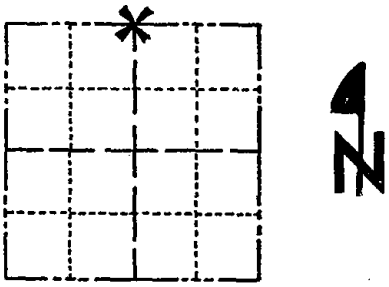

LOCATION
(Indicated by 'X')

BASIS FOR MONUMENT LOCATION

Show info such as: History of corner, with reference to Vol. and pg., dates, surveyor; exact description of monument replaced; if location computed, by taped or EDM traverse; landowner remarks, etc. (*Use reverse side if necessary*)

Set monument equidistant and on line between adjacent section corners. No evidence of any previous monumentation was found. There are no apparent possession lines in the area.

SEAL:

WISCONSIN
GREGORY P. RHINEHART
S-1478
FRIENDSHIP, WIS.
LAND SURVEYOR

DATA SHOWN HERE ON CERTIFIED CORRECT:

Gregory P Rhinehart

Registered Land Surveyor

DATE: 1-27-81

TIE SKETCH

Show at least four ties, also fence lines, roads, topo, size and type of witness trees' and if off road - best way to arrive at corner.

Mon. 1/2' E. of STEEL POST

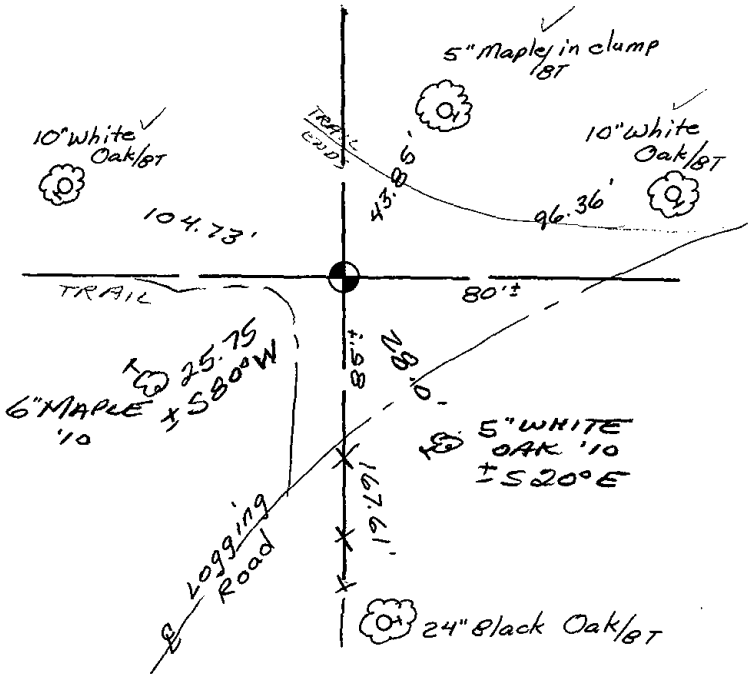

MAINTENANCE RECORD

Date	Init.	Remarks
1985	GR-SS	ALL OK
1-11-90	SS	ALL OK
2-2-95	JG	" "
5-31-00	JG-SS	" "
2-28-05	JG	OK
2-10-10	SS	2 NEW TIES

REVISED 1977