ADAMS COUNTY U.S. PUBLIC LAND SURVEY MONUMENT LOCATION RECORD

☐ FOUND
☐ SET
☒ RE-SET
☒ RE-TIED

CORNER # 35
SECTION 7
TOWNSHIP 16 NORTH
RANGE 6 EAST

SECTION 7

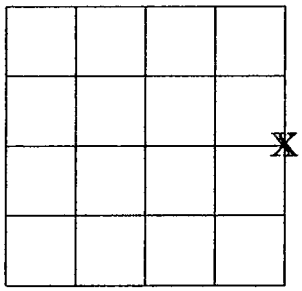

☒ LANDMARK ☐ BENCHMARK

CORNER IDENTITY BERNTSEN SURVEY NAIL SET

COUNTY COORDINATES: N. 188,522.97
E. 531,180.56

ELEVATION

WEATHER

DATE OF SURVEY June 24, 2013

SURVEY PARTY Dennis J. Christie, RLS

BASIS FOR MONUMENT LOCATION:

(DESCRIBE METHOD OF SURVEY AND CORNER AUTHENTICATION)

SET LOCATION FROM OCT 17, 1981
TIE SHEET AND SECTION SUMMARY
DISTANCES NORTH & SOUTH.

WISCONSIN
DENNIS J. CHRISTIE
S-1452
Green Bay, Wis.
LAND SURVEYOR

8/28/13

TIE SKETCH:

SHOW MINIMUM OF FOUR (4) HORIZONTAL TIE DISTANCES TO FIXED WITNESS MONUMENTS.
DESCRIBE ALL MONUMENTS FOUND OR SET.

DRAWING IS NOT TO SCALE.

LEGEND

BERNTSEN SURVEY NAIL SET
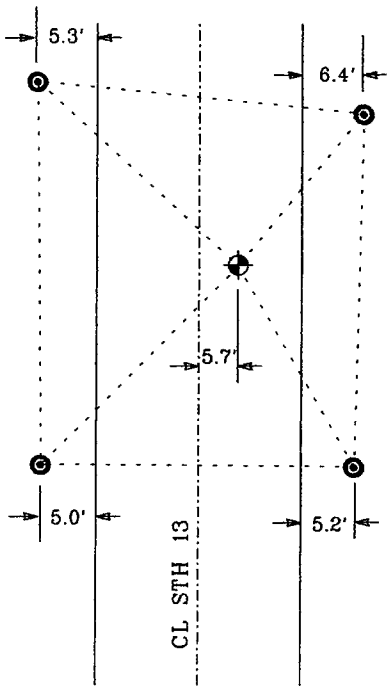
BERNTSEN MONUMENT A2BR30 SET