34 SECTION

TOWN

OB ADAMS COUNTY

COUNTY CORNER NO: 129

ROMPORTOL ID: 41606340000

PUBLIC LAND SURVEY MONUMENT RECORD


HARRISON TYPE OF MONUMENT: ADAMS COUNTY COORDINATES, NAD 83 (2007) N. **164674.399** E. <u>547155.939</u> **ELEVATION-**DATUM 11/15/2017 FIELD WORK DATE:

BASIS FOR MONUMENT LOCATION


1978 - 922 THOROUGHLY SEARCHED A LARGE AREA IN A FIELD FOR EVIDENCE OF THE ORIGINAL CORNER AND WITNESS. ALSO SEARCHED FOR M.C. SMITH'S BEARING TREE AND FOUND NO EVIDENCE. SET HARRISON MONUMENT ONLINE AND EQUADISTANT FROM THE SOUTH 1/4 CORNER OF SECTION 34 TO THE SOUTH 1/4 CORNER OF SECTION 35 AND TIED OUT.

1985 - PLS 878 THIS TIE SHEET SHOWS THE RELATIONSHIP BETWEEN THE SE CORNER OF SECTION 34, T16N, R6E, AS SET BY MID-STATE ASSOCIATES AND THE STONE SET BY M.C. SMITH IN 1923. THE LAND OWNER TO THE SOUTH, CLINTON STONE, WAS SHOWN THE SITUATION AND IS AWARE THAT HE HAS A LEGITIMATE CLAIM TO THE LAND BETWEEN THE LINE AS SET BY MID-STATE AND THE LINE AS SET BY M.C. SMITH. RE-TIED CORNER.

2017 - PLS 2994 FOUND A HARRISON MONUMENT 4" ABOVE THE SURFACE, THE STONE SET BY M.C. SMITH, 2 TIES AND 1 WITNESS TREE. THE MONUMENT AGREES WITH THE EXISTING TIES AND WITNESS TREE. THE CORNER LOCATION MONUMENTED WITH THE HARRISON HAS BEEN HELD AND ACCEPTED AS THE CORNER SINCE 1978. ACCEPTED THE HARRISON MONUMENT AS THE CORNER LOCATION. SET 2 NEW TIES AND MEASURED TO THE TIES, M.C. SMITH STONE AND WITNESS TREE.

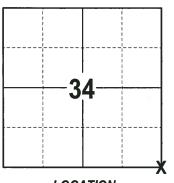

LOCATION (INDICATE CORNER BY "X")

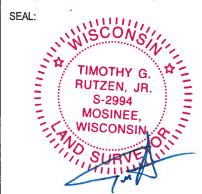

DATA SHOWN HERE ON THIS TIE SHEET IS CORRECT AND COMPLETE TO THE BEST OF MY KNOWLEDGE AND BELIEF.

PROFESSIONAL LAND SURVEYOR


12-417

- TIE SKETCH

NOTE: THE CORNER FALLS 41'± NORTH OF THE CENTERLINE OF THE EAST-WEST TRAIL AND 58'± EAST OF THE NORTH-SOUTH TRAIL.



- 3/4" x 18" IRON REBAR SET, 1.50#/FT 1-1/4" O.D. IROD PIPE FOUND
- 1" O.D. IRON PIPE FOUND
- HARRISON FOUND
- ✓ STEEL FENCE POST
- VINYL "T" POST
 - WITNESS TREE FOUND

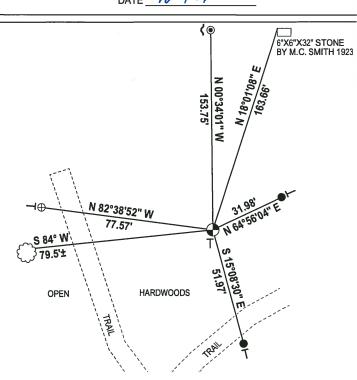

Government Land Corner Certificate


ADAMS	Coun	ty	
TYPE OF MONUMENT:			
STATE PLANE COORDINATES: N_			
E	. <u></u>		
ELEVATION — M.S.L. DATUM:			
THETA ANGLE:	· · · · · · · · · · · · · · · · · · ·		
FIELD BOOK:567	PAGE	24	
DRAWN BY: N_ SQUIRES			

BASIS FOR MONUMENT LOCATION

Show info such as: History of corner, with reference to Vol. and pg., dates, surveyor; exact description of monument replaced; if location computed, by taped or EDM traverse; landowner remarks, etc. (Use reverse side if necessary)

THOUROUGHLY SEARCHED A LARGE AREA IN FIELD FOR EVIDENCE OF ORIGINAL CORNER AND WITNESS ALSO SEARCHED FOR M.C. SMITH B.T. & COULD FIND NO EVIDENCE. SET THIS CORNER ON LINE & EQUA-DISTANT FROM THE SOUTH Y4 CORNER OF SECTION 34 TO THE SY CORNER OF SECTION 35. EDM. - THEODOLITE TRAVERSE.

129 CORNER NO. 34 SECTION 16 N TOWN 6 E RANGE

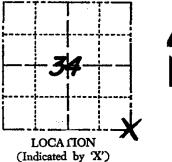

SEAL:



DATA SHOWN HERE ON CERTIFIED CORRECT:

Registered Land Surveyor

8-16-DATE:

TIE SKETCH

Show at least four ties, also fence lines, roads, topo, size and type of witness trees' and if off road - best way to


arrive at corner.

SEE ABK, TIE SHEET 5-9-1985 INFORMATION FOR ADDITIONAL

P.K. WITH SHINER IN Black Pine 8 DND SIGN 65

FENCE

DEAD 110

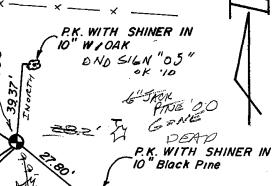


MAINTENANCE RECORD

Date	Init.	Remarks	15
11-4-85	GR	OK SEE K.E.T.	Ties &
2-7-90	GR	OK	
2-8-95	J6	OK	
2-17-00	55	Z NEW TIES	
4-5-05	56	1-GONE 1-NEW	
3-22-10	جع	2 NEW - SEE ARK	THE SHEET

P.K. WITH SHINER IN 10" DOUBLE Black Pine

P.K. WITH SHINER IN

20" DOUBLE Black Oak

 

Government Land Corner Certificate

ADAMS	_County
TYPE OF MONUMENT: HARRISON	
STATE PLANE COORDINATES: N	
<u>E</u>	
ELEVATION — M.S.L. DATUM:	· · · · · · · · · · · · · · · · · · ·
THETA ANGLE:	
FIELD BOOK: FILE	PAGE
DRAWN BY: A. B. K.	· · · · · · · · · · · · · · · · · · ·

BASIS FOR MONUMENT LOCATION

Show info such as: History of corner, with reference to Vol. and pg., dates, surveyor; exact description of monument replaced; if location computed, by taped or EDM traverse; landowner remarks, etc. (Use reverse side if necessary)

This tie sheet shows the relationship between the SE corner of Section 34, T16N, R6E, as set by Mid-State Associates and the stone set by M.C. Smith in 1923. In the survey of the SE¼ of the SE¼ of Section 34, the town line as set by Mid-State was held. Landowner to the South, Clinton Stone, was shown the situation and is aware that he has a legimate claim to the land between the line as set by Mid-State and the line as set by M.C. Smith.


See Section folder for more information.

 CORNER NO.
 129

 SECTION
 34

 TOWN
 16

 RANGE
 6

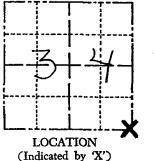



SEAL: (Indicate




DATA SHOWN HERE ON CERTIFIED CORRECT:

Registered Land Surveyor

DATE: 5/5/85

TIE SKETCH

Show at least four ties, also fence lines, roads, topo, size and type of witness trees' and if off road - best way to arrive at corner.

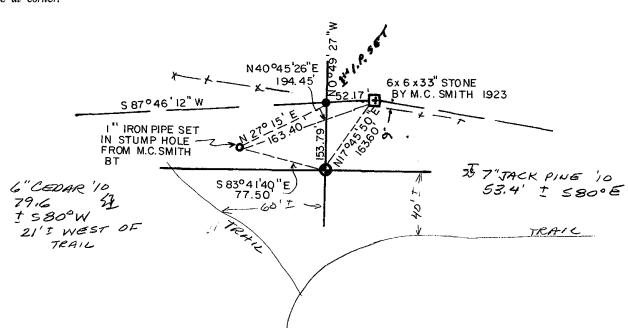

MAINTENANCE RECORD

DATE	BY WHOM	REMARKS
, , ,		
-		<u> </u>
-		
		·